

# Registration Statement

## OF CLAIMANT OF RIGHT TO APPROPRIATE GROUND WATER

2250  
on 80 acres

TO THE STATE ENGINEER OF OREGON:

I, HENRY G. STICKHOFF

of Brooks County of Marion

State of Oregon, do hereby make application for a certificate of registration as evidence of a right to appropriate ground water.

1. Source from which water is withdrawn is Pump well  
(Flowing well, pump well, infiltration trench, or tunnel)

2. Location is: 2 1/2 mi. No. and 2 1/2 mi. East of Brooks, Oregon  
(Approximate distance and direction from nearest city or town)

and is more particularly described as follows: 2175 feet west of 500 feet south of NE Corner Sec. 12

Beginning at the N.E. corner of James Webb D.L.C. #56; thence east along center  
(a) County Road #6, thence 540 feet south and parallel with east line of James Webb D.L.C. #56 to well.  
(Give distance and bearing to corner of section or other legal subdivision)

being within NE 1/4 NE 1/4 of Sec. 12 of Sec. 12, Twp. 6 S, Rge. 2 East  
(Smallest legal subdivision) (N. or S.) (E. or W.)

or (b) within limits of recorded platted property, town or city: not applicable

in Lot \_\_\_\_\_, Block \_\_\_\_\_ of \_\_\_\_\_  
(Name of plat or addition)

County of \_\_\_\_\_  
(If within city or town, give name)

3. Construction Work was begun on 5-10-53; was completed on 5-26-53  
(Date) (Date)

and the ground water claimed was first used for the purposes set out below on 5-26-53  
(Date)

since which time the water has been used intermittently for irrigation  
(Continuously or intermittently)

from May 1 to October 1 each year  
(Date) (Date)

4. Quantity of water claimed and used is 400 gallons per minute; \_\_\_\_\_ acre feet per year.

5. Purpose or Purposes for which water is used irrigation

(Domestic, irrigation, municipal, manufacturing, industrial, etc.)

6. Description of Well: Depth 142 feet. Type drilled  
(Dug or drilled)

diameter 10 inches. Elevation of ground at well site 329 feet 157 feet, mean sea level.  
(As near as known)

Depth to water table 25 feet.

7. Capacity of Well: 350 g.p.m. with 66 feet drawdown. Rec. \_\_\_\_\_  
300 g.p.m. with 79 feet drawdown. total setting 240  
250 g.p.m. with 68  
200 g.p.m. with 54

Date of test May 29, 1953

If Flowing Well: Measured discharge \_\_\_\_\_ g.p.m. on \_\_\_\_\_  
(Date)

Shut-in pressure at ground surface \_\_\_\_\_ lbs. per sq. in. on \_\_\_\_\_  
(Date)

Water is controlled by \_\_\_\_\_  
(Cap, valve, etc.)



If log of well is not available, give name and address of driller. Irving Sears. Disc #8

Rt. #1. Gervias, Oregon

11. Infiltration Trench: Covered or open not known

Dimensions: Length \_\_\_\_\_ ft. Minimum depth \_\_\_\_\_ ft. Maximum depth \_\_\_\_\_ ft.

Bottom width \_\_\_\_\_ ft. Discharge \_\_\_\_\_ g.p.m. Date of test \_\_\_\_\_

12. Tunnel: Type of lining not known

Dimensions: \_\_\_\_\_  
(Length, course, and cross sectional size)

Position of water bearing stratum with reference to portal of tunnel \_\_\_\_\_

Log of tunnel: (Preceding table for log of well may be used, if desired. Give footage from portal and character of materials, as pertinent.)

13. Pumping Equipment:

(a) Pump Johnson Turbine Capacity 400 g.p.m.  
(Make, type and size)

(b) Motor 30 H.P.  
(Type and horsepower)

14. Location of area irrigated or to be irrigated, or place of use if for purposes other than irrigation.


Township North or South	Range E. or W. of Willamette Meridian	Section	Forty-acre Tract	Number Acres To Be Irrigated	Date of Reclamation
26 S	R 2 W	12		100 acres	not known
6 S	2 W	1	SW <sup>1</sup> / <sub>4</sub> of SE <sup>1</sup> / <sub>4</sub>	6	5/28/53
6 S	2 W	1	SE <sup>1</sup> / <sub>4</sub> of SE <sup>1</sup> / <sub>4</sub>	6	"
6 S	1 W	6	SW <sup>1</sup> / <sub>4</sub> of SW <sup>1</sup> / <sub>4</sub>	3	"
6 S	1 W	7	NW <sup>1</sup> / <sub>4</sub> of NW <sup>1</sup> / <sub>4</sub>	12	"
6 S	2 W	12	NW <sup>1</sup> / <sub>4</sub> of NE <sup>1</sup> / <sub>4</sub>	30	"
6 S	2 W	12	NE <sup>1</sup> / <sub>4</sub> of NE <sup>1</sup> / <sub>4</sub>	30	"
				<u>87</u>	

15. If the ground water supply is supplemental to an existing water supply, identification of any application for a permit, permit, certificate or adjudicated right to appropriate water made or held by the registrant.

None

Township 6 S. Range 2 W., W.M.

Nbrth

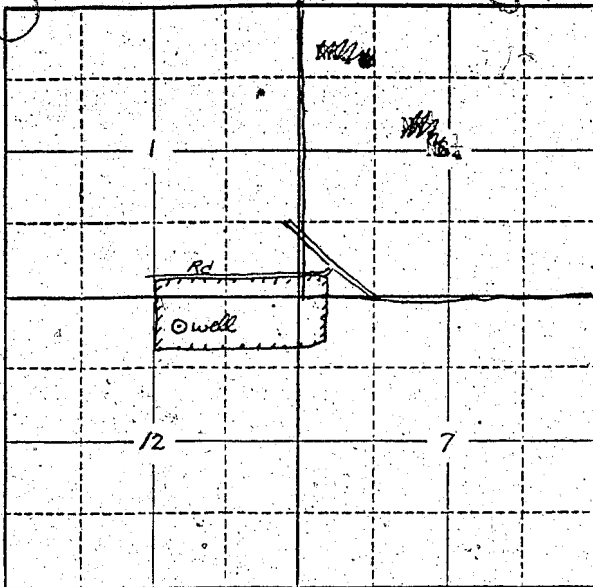

Locate well and acreage of irrigated land on plat.

Scale: 2" = 1 Mile

STATE OF OREGON

County of Marion

} ss.

I, HENRY G. STOCKHOFF, being first duly sworn, do hereby certify that I have read the foregoing Registration Statement and that all of the items therein contained are true to the best of my knowledge and belief.

*Henry G. Stockhoff*  
(Signature of Registrant)

Subscribed and sworn to before me this 5 day of February, 1958.

My commission expires December 2, 1961

*W. A. Standley*  
NOTARY PUBLIC FOR OREGON  
MY COMMISSION EXPIRES, DEC. 2, 1961.

(SEAL)

CERTIFICATE OF REGISTRATION

STATE OF OREGON

County of Marion

} ss.

This is to certify that the foregoing Registration Statement was received in the office of the State Engineer on the 5 day of February, 1958, at 4:00 o'clock P.M. and has been duly recorded in said office in Book No. 5 of Registration Statements on page 234.

Witness my hand this 7 day of May, 1958

*W. A. Standley*  
(State Engineer)

By \_\_\_\_\_ (Deputy)