

Registration Statement

OF CLAIMANT OF RIGHT TO APPROPRIATE GROUND WATER

(Under Chapter 708, Oregon Laws 1955.)

TO THE STATE ENGINEER OF OREGON:

I, ALBERT HUBERT JOHNSONof RT 1 Box 237 WOODBURN County of MARIONState of OREGON, do hereby make application for a certificate of registration as evidence of a right to appropriate ground water.1. Source from which water is withdrawn is Pump well
(Flowing well, pump well, infiltration trench, or tunnel)2. Location is: 4 MILES N.W. OF WOODBURN
(Approximate distance and direction from nearest city or town)

and is more particularly described as follows:

Approximately 500 FT EAST and 1400 FT SOUTH of NW Corner Section 5(a) 500 FT NEARLY WEST OF THE SOUTHEAST CORNER
(Give distance and bearing to corner of section or other legal subdivision)being within PTERS SW 1/4 NW 1/4 of Sec. 5, Twp. 5 SOUTH, Rge. 1 WEST
(Smallest legal subdivision) (N. or S.) (E. or W.)

or (b) within limits of recorded platted property, town or city:

in Lot _____, Block _____ of _____
(Name of plat or addition)County of _____
(If within city or town, give name)3. Construction Work was begun on July 1 - 55; was completed on July 11 - 1955
(Date) (Date)and the ground water claimed was first used for the purposes set out below on JUNE 1955
(Date)since which time the water has been used CONT. DOMESTIC WATER IRRIGATION
(Continuously or intermittently)from JUNE 1955 to SEPT 1955
(Date) (Date)4. Quantity of water claimed and used is 2.5 gallons per minute; _____ acre
feet per year.5. Purpose or Purposes for which water is used DOMESTIC - IRRIGATION
(Domestic, irrigation, municipal, manufacturing, industrial, etc.)6. Description of Well: Depth 113 feet. Type DRILL
(Dug or drilled)
diameter 6 inches. Elevation of ground at well site 176 feet, mean sea level.
(As near as known)
Depth to water table 25 feet.7. Capacity of Well: 50 g.p.m. with _____ feet drawdown.
_____ g.p.m. with _____ feet drawdown.Date of test May 11 - 1955If Flowing Well: Measured discharge _____ g.p.m. on _____
(Date)Shut-in pressure at ground surface _____ lbs. per sq. in. on _____
(Date)Water is controlled by _____
(Cap, valve, etc.)

8. **Casing:** (Give diameter, commercial specifications and depth below ground surface of each casing size.)

6-	inch diameter	Top	from Top	to 113	feet
	inch diameter	welded joints	from	to	feet
	inch diameter		from	to	feet
	inch diameter		from	to	feet

Describe and show depth of shoe, plug, adapter, liner or other details: _____

Welded Spring Steel Shoe

9. Perforated Casings or Screens:

70 Perforation 07 Screen from to
(Number per foot and size of perforations, or describe screen)

from to
from to
from to
from to

10. **Log of Well:** (Describe each stratum or formation clearly, indicate if water bearing, and give thickness and depth as indicated.)

[illegible]

GR-935 A


- Position of water bearing stratum with reference to portal of tunnel

13. Pumping Equipment:

Pump to be change to 3 or 5 H.P. Summer 1958


- (b) Motor KL 2 H.P.
(Type and horsepower)

14. Location of area irrigated or to be irrigated, or place of use if for purposes other than irrigation.

Township North or South	Range E. or W. of Willamette Meridian	Section	Forty-acre Tract	Number Acres To Be Irrigated	Date of Reclamation
SOUTH				3	JUNE 1955
SOUTH	WEST				
					TO IRRIGATE 5 ACRES MORE WHEN CLEARED
55	TW	5	SW 1/4 NW 1/4	3	JUNE 1955
55	16	5	SW 1/4 NW 1/4	5	Summer 1958
				8	

15. If the ground water supply is supplemental to an existing water supply, identification of any application for a permit, permit, certificate or adjudicated right to appropriate water made or held by the registrant.

North

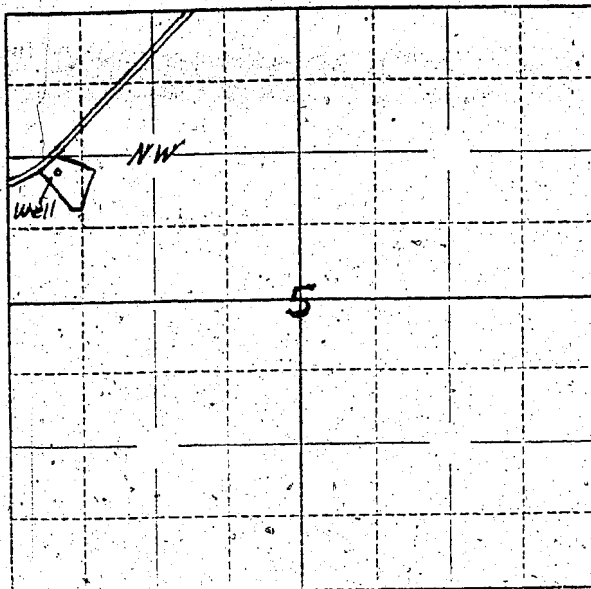

Scale: $\frac{1}{4}$ " = 1 Mile

County of _____

55

(Signature of Registrant)

My commission expires 12th June 1961

(Notary Public

CERTIFICATE OF REGISTRATION

County of Marion

SS

~~Construction chalked completed by x-x-x-x-x-xx-x-x-x-to-x-x-and-the water-completely-applied-n-x~~

~~X-X~~

Witness my hand this 7th day of May, 1958

(State Engineer)

By

(Deputy)

GR-935 C