

RECEIVED
FEB 6 1953
STATE ENGINEER
SALEM, OREGON

Registration No. GR - 985

Certificate No. GR - 936

Registration Statement

OF CLAIMANT OF RIGHT TO APPROPRIATE GROUND WATER

TO THE STATE ENGINEER OF OREGON:

I, Gordon and Hazel Hofer
of Rt. 2, Box 336 B, Albany County of Linn
(Mailing address)

State of Oregon do hereby make application for a certificate of registration as evidence of a right to appropriate ground water.

1. Source from which water is withdrawn is Pump Well No. 1
(Flowing well, pump well, infiltration trench, or tunnel)

2. Location is: 7 miles west of Jefferson, Oregon
(Approximate distance and direction from nearest city or town)

and is more particularly described as follows:

(a) N. 38° 30' W. 57.70 chains from SE corner S. 12, T. 10 S., R. 1 W.
(Give distance and bearing to corner of section or other legal subdivision)

being within SW 1/4 of NE 1/4 of Sec. 12, Twp. 10 S., Rge. 1 W.
(Smallest legal subdivision) (N. or S.) (E. or W.)

or (b) within limits of recorded platted property, town or city:

in Lot _____, Block _____ of _____
(Name of plat or addition)

County of Linn
(If within city or town, give name)

3. Construction Work was begun on May 1952; was completed on May 1952
(Date) (Date)

and the ground water claimed was first used for the purposes set out below on May 1952
(Date)

since which time the water has been used continuously
(Continuously or intermittently)

from May 1952 to present time
(Date) (Date)

4. Quantity of water claimed and used is 250 gallons per minute; 54.5 acre feet per year.

5. Purpose or Purposes for which water is used Irrigation

(Domestic, irrigation, municipal, manufacturing, industrial, etc.)

6. Description of Well: Depth 36 feet. Type Drilled
(Dug or drilled)

diameter 10 inches. Elevation of ground at well site 185 feet, mean sea level.
(As near as known)

Depth to water table 14 feet.

7. Capacity of Well: 300 g.p.m. with 3 feet drawdown.

g.p.m. with _____ feet drawdown.

Date of test May 1952

If Flowing _____ measured discharge _____ g.p.m. on _____
(Date)

Shut-in pressure _____ ground surface _____ lbs. per sq. in. on _____
(Date)

Water is controlled by _____
(Cap, valve, etc.)

8. **Casing:** (Give diameter, commercial specifications and depth below ground surface of each casing size.)

10 inch diameter steel casing from 0 to 36 feet
 inch diameter from to feet
 inch diameter from to feet
 inch diameter from to feet

Describe and show depth of shoe, plug, adapter, liner or other details:

9. **Perforated Casings or Screens:**

Slot perforations from 28 to 36
(Number per foot and size of perforations, or describe screen)
 from to
 from to
 from to

10. **Log of Well:** (Describe each stratum or formation clearly, indicate if water bearing, and give thickness and depth as indicated.)

MATERIAL	Thickness (Feet)	Depth to Bottom (Feet)
Not available		

If log of well is not available, give name and address of driller. Bill Hamilton Drilling Co.
838 East third Ave., Albany, Oregon

11. Infiltration Trench: Covered or open
 Dimensions: Length ft. Minimum depth ft. Maximum depth ft.
 Bottom width ft. Discharge g.p.m. Date of test

12. Tunnel: Type of lining
 Dimensions:
(Length, course, and cross sectional size)
 Position of water bearing stratum with reference to portal of tunnel

Log of tunnel: (Preceding table for log of well may be used, if desired. Give footage from portal and character of materials, as pertinent.)

13. Pumping Equipment:
 (a) Pump Pacific 3" centrifugal Capacity 400 g.p.m.
(Make, type and size)
 (b) Motor 15 H. P. electric
(Type and horsepower)

14. Location of area irrigated or to be irrigated, or place of use if for purposes other than irrigation.


Township North or South	Range E. or W. of Willamette Meridian	Section	Forty-acre Tract	Number Acres To Be Irrigated	Date of Reclamation
10 S	4 W	12	SE $\frac{1}{4}$ of NW $\frac{1}{4}$	1.6	May 1952
10 S	4 W	12	NE $\frac{1}{4}$ of SW $\frac{1}{4}$	1.0	" "
10 S	4 W	12	SW $\frac{1}{4}$ of NE $\frac{1}{4}$	11.0	" "
10 S	4 W	12	NW $\frac{1}{4}$ of SE $\frac{1}{4}$	8.2	" "
				21.8	

All that part and portion of the property hereinafter described lying and being situated easterly of the center line of the county road running northerly and southerly across the hereinafter described premises, to-wit: Beginning at an iron pipe 2 x 24" which is North 12.41 chains distant from the N. E. corner of the D.L.C. of Elias A. Johnson, being Not. No. 1717 and Claim No. 74, in Tp. 10 S., R. 4 W. of the Willamette Meridian, Oregon, being Not. West, parallel with North line of the D.L.C. of John McCoy, being Claim No. 38 in said township and range, 64.70 chains to an iron pipe 1x20" which is west 32.61 chains thence North 11.40 chains to the interior corner of north line of said Claim No. 38; thence North along west line of said claim 15.45 chains to an iron rod 1x24" which is south 14.43 chains distant from the N. W. corner of north projection of said Claim No. 38; thence East, parallel with north line of said John McCoy's claim, 64.63 chains to an iron rod 1x20" which is west 32.61 chains distant from east line of said claim; thence South 26.94 chains to the place of beginning, containing 174 acres, more or less, lying in Linn County, State of Oregon.

The premises above described hereby conveyed contains 100 acres of land, more or less. ALSO: Beginning at a point 6.02 chains North 5.71 chains West from the Southwest corner of Section 7, Township 10 South, Range 3 West of the Will. Mer. in Linn County, Oregon, and running thence North 39.87 chains; thence East 4.51 $\frac{1}{2}$ chains; thence South 39.87 chains; thence West 4.51 $\frac{1}{2}$ to the place of beginning, containing 18 acres in Linn County, Oregon.

15. If the ground water supply is supplemental to an existing water supply, identification of any application for a permit, permit, certificate or adjudicated right to appropriate water made or held by the registrant.

Township 10 S Range 4 W, W.M.
North

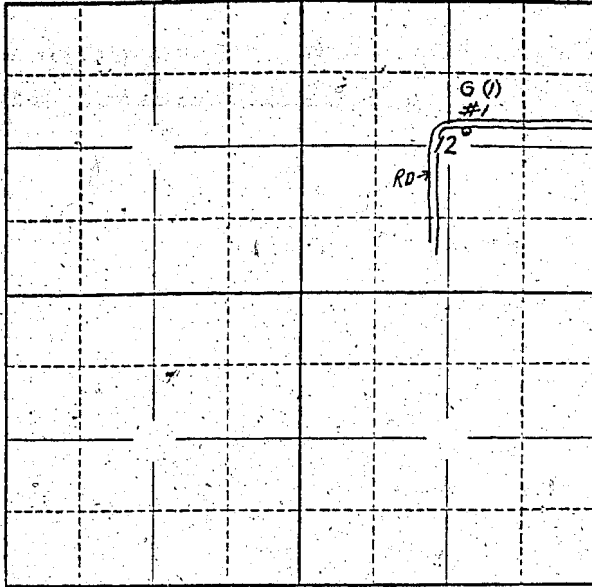

Locate well and acreage of irrigated land on plat.
Scale: 2" = 1 Mile

STATE OF OREGON

County of Linn } ss.

I, Gordon and Hazel Hofer, being first duly sworn, do hereby certify that I have read the foregoing Registration Statement and that all of the items therein contained are true to the best of my knowledge and belief.

Gordon Hofer
(Signature of Registrant)

Subscribed and sworn to before me this 29 day of February, 1958.

My commission expires February 28, 1959
(Notary Public)

(SEAL)

CERTIFICATE OF REGISTRATION

STATE OF OREGON } ss.
County of Marion

This is to certify that the foregoing Registration Statement was received in the office of the State Engineer on the 6 day of February, 1958, at 8:00 o'clock A. M. and has been duly recorded in said office in Book No. 5 of Registration Statements on page 936.

Witness my hand this 7 day of May, 1958.

Lewis A. Standish
(State Engineer)

By _____
(Deputy)