

RECEIVED  
FEB 7 1953  
STATE ENGINEER  
SALEAS, OREGON

Registration No. GR - 936  
Certificate No. GR - 937

# Registration Statement

## OF CLAIMANT OF RIGHT TO APPROPRIATE GROUND WATER

TO THE STATE ENGINEER OF OREGON:

I, Gordon and Hazel Hoefler

of Rt. 1, Box 336 B, Alban  
(Mailing address)

County of Linn

State of Oregon do hereby make application for a certificate of registration as evidence of a right to appropriate ground water.

1. Source from which water is withdrawn is Pump Well No. 2

(Flowing well, pump well, infiltration trench, or tunnel)

2. Location is: 7 miles west of Jefferson, Oregon

(Approximate distance and direction from nearest city or town)

and is more particularly described as follows:

(a) N. 5° 45' W. 40.60 chains from the SE corner of S. 12, T. 10 S, R. 4 W.

(Give distance and bearing to corner of section or other legal subdivision)

being within SE 1/4 of NE 1/4

(Smallest legal subdivision)

of Sec. 12

Twp. 10 S

Rge. 4 W.

(N. or S.)

(E. or W.)

or (b) within limits of recorded platted property, town or city:

in Lot \_\_\_\_\_, Block \_\_\_\_\_ of \_\_\_\_\_

(Name of plat or addition)

County of Linn

(If within city or town, give name)

3. Construction Work was begun on May 1952

(Date)

; was completed on May 1952

(Date)

and the ground water claimed was first used for the purposes set out below on June 1952

(Date)

since which time the water has been used continuously

(Continuously or intermittently)

from June 1952 to present time

(Date)

(Date)

4. Quantity of water claimed and used is 200 gallons per minute;

10.75 acre

feet per year.

5. Purpose or Purposes for which water is used Irrigation

(Domestic, irrigation, municipal, manufacturing, industrial, etc.)

6. Description of Well: Depth 36 feet. Type Drilled

(Dig or drilled)

diameter 10 inches. Elevation of ground at well site 185.2

(As near as known)

feet, mean sea level.

Depth to water table 12 feet.

7. Capacity of Well: 200 g.p.m. with 8 feet drawdown.

\_\_\_\_\_ g.p.m. with \_\_\_\_\_ feet drawdown.

Date of test June 1952

If Flowing Well: Measured discharge \_\_\_\_\_ g.p.m. on \_\_\_\_\_

(Date)

Shut-in pressure at ground surface \_\_\_\_\_ lbs. per sq. in. on \_\_\_\_\_

(Date)


Water is controlled by \_\_\_\_\_

(Cap, valve, etc.)





Township 10 S Range 4 W, W.M.  
North

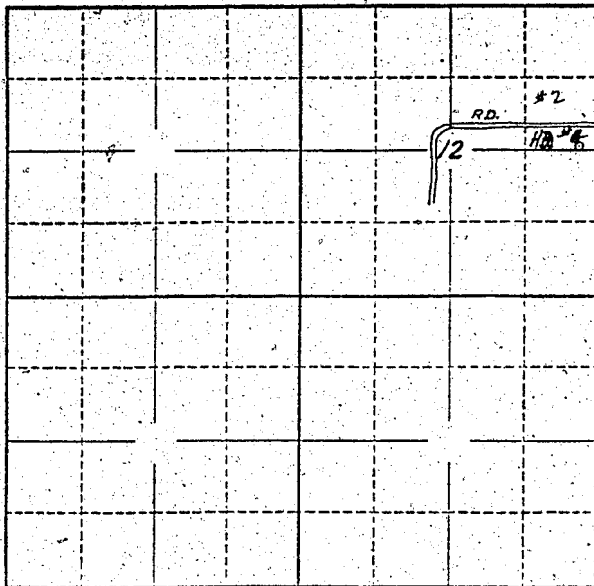

Locate well and acreage of irrigated land on plat.  
Scale: 2" = 1 Mile

STATE OF OREGON

County of Linn

} ss.

I, Gordon and Hazel Hofer, being first duly sworn, do hereby certify that I have read the foregoing Registration Statement and that all of the items therein contained are true to the best of my knowledge and belief.

Gordon Hofer  
(Signature of Registrant)

Subscribed and sworn to before me this 27 day of February, 1958

My commission expires 7-6-58

[Signature]  
(Notary Public)

(SEAL)

**CERTIFICATE OF REGISTRATION**

STATE OF OREGON

County of Marion

} ss.

This is to certify that the foregoing Registration Statement was received in the office of the State Engineer on the 6 day of February, 1958, at 8:00 o'clock A. M. and has been duly recorded in said office in Book No. 5 of Registration Statements on page 937

Witness my hand this 7 day of May, 1958

[Signature]  
(State Engineer)

By [Signature]  
(Deputy)