

RECEIVED
MAY 10 1953
STATE ENGINEER
SALEM, OREGON

Registration No. GR - 987

Certificate No. GR - 938

Registration Statement

OF CLAIMANT OF RIGHT TO APPROPRIATE GROUND WATER

TO THE STATE ENGINEER OF OREGON:

I, Gordon and Hazel Hofer

of Rt. 2, Box 336 B, Albany
(Mailing address)

County of Linn

State of Oregon, do hereby make application for a certificate of registration as evidence of a right to appropriate ground water.

1. Source from which water is withdrawn is Pump Well No. 3

(Flowing well, pump well, infiltration trench, or tunnel)

2. Location is: 7 miles West of Jefferson, Oregon

(Approximate distance and direction from nearest city or town)

and is more particularly described as follows:

(a) N. 21° 30' W. 38.50 chains from SE corner S. 12, T. 10 S., R. 4 W.

(Give distance and bearing to corner of section or other legal subdivision)

being within NE 1/4 of SE 1/4

(Smallest legal subdivision)

of Sec. 12

Twp. 10 S.

Rge. 4 W.

(E. or W.)

or (b) within limits of recorded platted property, town or city:

in Lot _____, Block _____ of _____

(Name of plat or addition)

County of Linn

(If within city or town, give name)

3. Construction Work was begun on June 1940

(Date)

; was completed on June 1940

(Date)

and the ground water claimed was first used for the purposes set out below on June 1940

(Date)

since which time the water has been used continuously

(Continuously or Intermittently)

from June 1940

(Date)

to October 1954

(Date)

but will use again

4. Quantity of water claimed and used is 250 gallons per minute; 34.25 acre feet per year.

5. Purpose or Purposes for which water is used Irrigation

(Domestic, irrigation, municipal, manufacturing, industrial, etc.)

6. Description of Well: Depth 28 feet. Type Drilled

(Dug or drilled)

diameter 10 inches. Elevation of ground at well site 184.6 feet, mean sea level.

(As near as known)

Depth to water table 12 feet.

7. Capacity of Well: 250 g.p.m. with 8 feet drawdown.

_____ g.p.m. with _____ feet drawdown.

Date of test June 1940

If Flowing Well: Measured discharge _____ g.p.m. on _____

(Date)


Shut-in pressure at ground surface _____ lbs. per sq. in. on _____

(Date)

Water is controlled by _____

(Cap. valve, etc.)

Township 10 S Range 4 W, W.M.
North

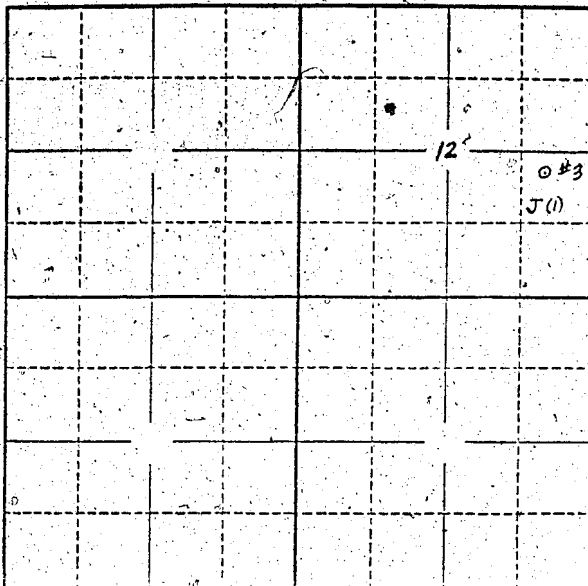

Locate well and acreage of irrigated land on plat.
Scale: 2" = 1 Mile

STATE OF OREGON

County of Linn

ss.

I, Gordon and Hazel Hofer, being first duly sworn, do hereby certify that I have read the foregoing Registration Statement and that all of the items therein contained are true to the best of my knowledge and belief.

Gordon Hofer
(Signature of Registrant)

Subscribed and sworn to before me this 7 day of July, 1958

My commission expires 7-6-58

(Notary Public)

(SEAL)

CERTIFICATE OF REGISTRATION

STATE OF OREGON

County of Marion

ss.

This is to certify that the foregoing Registration Statement was received in the office of the State Engineer on the 6 day of February, 1958, at 8:00 o'clock A. M. and has been duly recorded in said office in Book No. 5 of Registration Statements on page 938

Witness my hand this 7 day of May, 1958

Laura A. Stanley
(State Engineer)

By _____ (Deputy)