

**Registration Statement****OF CLAIMANT OF RIGHT TO APPROPRIATE GROUND WATER**

(Under Chapter 708, Oregon Laws 1955.)

TO THE STATE ENGINEER OF OREGON:

I, Robert S. Hartof Jefferson County of MarionState of Or, do hereby make application for a certificate of registration as evidence of a right to appropriate ground water.1. Source from which water is withdrawn is pump well  
(Flowing well, pump well, infiltration trench, or tunnel)2. Location is: 2 1/2 miles S.E. of Jefferson  
(Approximate distance and direction from nearest city or town)

and is more particularly described as follows:

(a) 600' W x 500' S OF E 1/4 CORNER SECTION 13  
(Give distance and bearing to corner of section or other legal subdivision)being within N 1/4 S E 1/4 of Sec. 13, Twp. 10 S, Rge. 3 W  
(Smallest legal subdivision) (N. or S.) (E. or W.)

or (b) within limits of recorded platted property, town or city:

in Lot \_\_\_\_\_, Block \_\_\_\_\_ of \_\_\_\_\_  
(Name of plat or addition)County of \_\_\_\_\_  
(If within city or town, give name)3. Construction Work was begun on 1940; was completed on 1940  
(Date) (Date)and the ground water claimed was first used for the purposes set out below on 1940  
(Date)since which time the water has been used continuously during summers  
(Continuously or intermittently)from 1940 to Feb. 1956  
(Date) (Date)4. Quantity of water claimed and used is 400 gallons per minute; \_\_\_\_\_ acre feet per year.5. Purpose or Purposes for which water is used irrigation

(Domestic, irrigation, municipal, manufacturing, industrial, etc.)

6. Description of Well: Depth 15 feet. Type dug  
(Dug or drilled)diameter 30 inches. Elevation of ground at well site 228 230' feet, mean sea level.  
(As near as known)Depth to water table 8 feet.7. Capacity of Well: 600 g.p.m. with 3 feet drawdown.

\_\_\_\_\_ g.p.m. with \_\_\_\_\_ feet drawdown.


Date of test 1940If Flowing Well: Measured discharge \_\_\_\_\_ g.p.m. on \_\_\_\_\_  
(Date)Shut-in pressure at ground surface \_\_\_\_\_ lbs. per sq. in. on \_\_\_\_\_  
(Date)Water is controlled by sprinklers  
(Cap, valve, etc.)





Township 10.5 Range 3.4, W.M.

North

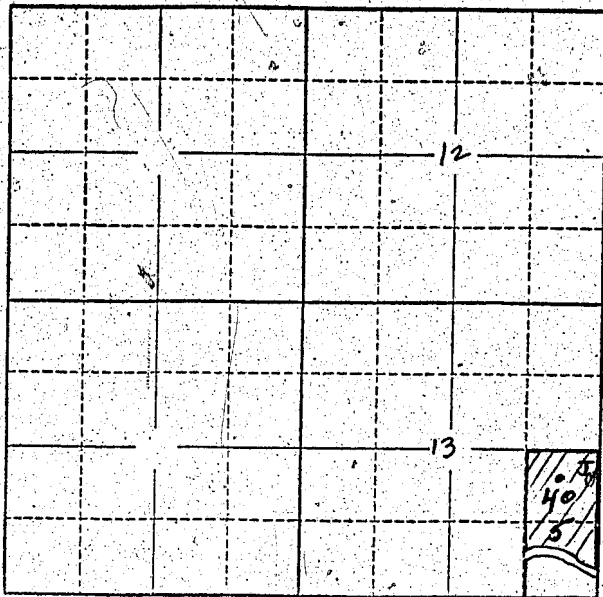

Locate well and acreage of irrigated land on plat.

Scale: 2" = 1 Mile

STATE OF OREGON

County of Marion } ss.

I, Robert S. Hart, being first duly sworn, do hereby certify that I have read the foregoing Registration Statement and that all of the items therein contained are true to the best of my knowledge and belief.

Robert S. Hart  
(Signature of Registrant)

Subscribed and sworn to before me this 31<sup>st</sup> day of January, 1956

My commission expires Sept 8, 1956 Chas. L. Huber  
(Notary Public)

(SEAL)

**CERTIFICATE OF REGISTRATION**

STATE OF OREGON }  
County of Marion } ss.

This is to certify that the foregoing Registration Statement was received in the office of the State Engineer on the 31<sup>st</sup> day of January, 1956, at 2:30 o'clock P.M. and has been duly recorded in said office in Book No. 1 of Registration Statements on page GR-93 C

Construction shall be completed by 10 and the water completely applied to beneficial use by 10

Witness my hand this 12<sup>th</sup> day of April, 1956  
Lewis A. Stanley  
(State Engineer)

By \_\_\_\_\_  
(Deputy)