

Registration Statement CERTIFICATE NO. GR-1438

OF CLAIMANT OF RIGHT TO APPROPRIATE GROUND WATER

(Under Chapter 703, Oregon Laws 1955.)

TO THE STATE ENGINEER OF OREGON:

I, Harold F Johnson

of Hillsboro County of Washington

State of Oregon, do hereby make application for a certificate of registration as evidence of a right to appropriate ground water.

1. Source from which water is withdrawn is Pump Well
(Flowing well, pump well, infiltration trench, or tunnel)

2. Location is: SE of Hillsboro 1/4 mi from junction of River Road and Minter Road
(Approximate distance and direction from nearest city or town)

and is more particularly described as follows: Beginning at a point on the westerly line of Newton Acres 603.3 feet from a stump at the NW corner of Lot 1
(Give distance and bearing to corner of section or other legal subdivision)

(a) SW 1/4 of 8 being within Newton Acres of Sec. 8 Twp. 1 south Rge. 2 W
(Smallest legal subdivision) (N. or S.) (E. or W.)

or (b) within limits of recorded platted property, town or city:

in Lot _____, Block _____ of _____
(Name of plat or addition)

County of Washington
(If within city or town, give name)

3. Construction Work was begun on Jan 1947; was completed on Jan 1947
(Date) (Date)

and the ground water claimed was first used for the purposes set out below on May 1947
(Date)

since which time the water has been used continuously
(Continuously or intermittently)

from May 1947 to present
(Date) (Date)

4. Quantity of water claimed and used is 50-15 gallons per minute; unknown acre feet per year.

5. Purpose or Purposes for which water is used domestic and some garden and pasture irrigation (approximately 2 acres)
(Domestic, irrigation, municipal, manufacturing, industrial, etc.)

6. Description of Well: Depth 40 feet. Type Drilled
(Dug or drilled)

diameter 6 inches. Elevation of ground at well site 700 feet, mean sea level.
(As near as known)

Depth to water table 12 feet.

7. Capacity of Well: 20 g.p.m. with 30 feet drawdown.

_____ g.p.m. with _____ feet drawdown.

Date of test _____

If Flowing Well: Measured discharge _____ g.p.m. on _____
(Date)

Shut-in pressure at ground surface _____ lbs. per sq. in. on _____
(Date)

Water is controlled by _____
(Cap, valve, etc.)

Well located 2650 S.W. 33rd St. from NW Corner Sec. 8, T 15, R 2 W.

8. Casing: (Give diameter, commercial specifications and depth below ground surface of each casing size.)

6 inch diameter steel Casing from 30 to 35 feet
inch diameter from to feet
inch diameter from to feet
inch diameter from to feet

Describe and show depth of shoe, plug, adapter, liner or other details:

9. Perforated Casings or Screens:

from to
(Number per foot and size of perforations, or describe screen)
from to
from to
from to

10. Log of Well: (Describe each stratum or formation clearly, indicate if water bearing, and give thickness and depth as indicated.)

MATERIAL	Thickness (Feet)	Depth to Bottom (Feet)
None available		
TOP Soil - Amity	12	12
Blue Clay		Below 12 Feet to depth of well.
	28	40 FT

If log of well is not available, give name and address of driller: Carl Millet

1440 NW 317 Ave Hillbore, Ore

11. Infiltration Trench: Covered or open

Dimensions: Length ft. Minimum depth ft. Maximum depth ft.

Bottom width ft. Discharge g.p.m. Date of test

12. Tunnel: Type of lining

Dimensions:
(Length, course, and cross sectional size)

Position of water bearing stratum with reference to portal of tunnel

Log of tunnel: (Preceding table for log of well may be used, if desired. Give footage from portal and character of materials, as pertinent.)

13. Pumping Equipment:

(a) Pump Burkley 0-40 Capacity 15 g.p.m.
(Make, type and size)


(b) Motor Electric 1/2 HP C
(Type and horsepower)

14. Location of area irrigated or to be irrigated, or place of use if for purposes other than irrigation.

Township North or South	Range E. or W. of Willamette Meridian	Section	Forty-acre Tract	Number Acres To Be Irrigated	Date of Reclamation
1 S	2 W	8	SW quarter of 6008	2	May 1947
1 S	2 W	8	SW 1/4 of NW 1/4	1.0	May 1947
1 S	2 W	8	SE 1/4 of NW 1/4	1.0	
				<u>2.0</u>	
"	"	8	NE 1/4 of SW 1/4	0.5	
				<u>2.5</u>	

15. If the ground water supply is supplemental to an existing water supply, identification of any application for a permit, permit, certificate or adjudicated right to appropriate water made or held by the registrant.

Township 1 South Range 2 W, W.M.
North

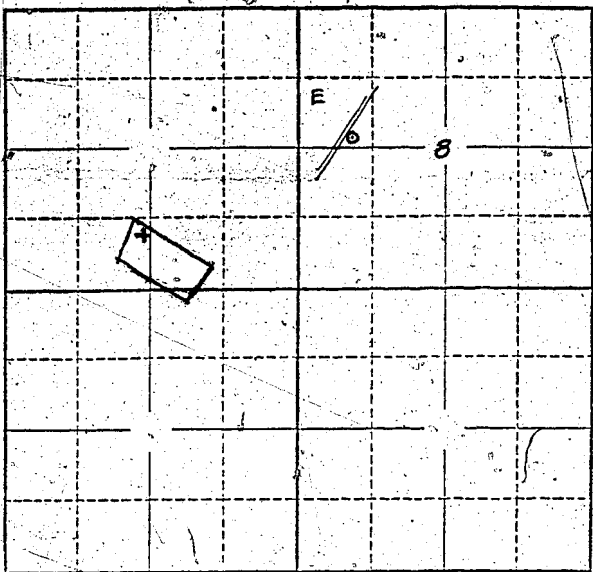

Locate well and acreage of irrigated land on plat.
Scale: 2" = 1 Mile

STATE OF OREGON

County of Washington } ss.

I, Harold F. Johnson, being first duly sworn, do hereby certify that I have read the foregoing Registration Statement and that all of the items therein contained are true to the best of my knowledge and belief.

Harold F. Johnson
(Signature of Registrant)

Subscribed and sworn to before me this 9th day of January, 1958

My commission expires 10/17/61 Janette Nelson
(Notary Public)

(SEAL)

CERTIFICATE OF REGISTRATION

STATE OF OREGON

County of Marion } ss.

This is to certify that the foregoing Registration Statement was received in the office of the State Engineer on the 9th day of FEBRUARY, 1958, at o'clock A. M. and has been duly recorded in said office in Book No. 7 of Registration Statements on page GR 1438

~~Construction shall be completed by xxxxxxxxxxxxxxxxx 19xx and the water completely applied to beneficial use by xxxxxxxxxxxxxxxxx 19xx.~~

Witness my hand this 1st day of December, 1958

(State Engineer)

By
(Deputy)

GR-1438