

Well # 1

Registration No. GR - 973

Certificate No. GR - 913

RECEIVED
STATE ENGINEER
SALES, OREGON

Registration Statement

OF CLAIMANT OF RIGHT TO APPROPRIATE GROUND WATER

TO THE STATE ENGINEER OF OREGON:

I, Green Brothers

of Box 72, Coburg County of Lane
(Mailing address)

State of Oregon, do hereby make application for a certificate of registration as evidence of a right to appropriate ground water.

1. Source from which water is withdrawn is Pump Well # 1
(Flowing well, pump well, infiltration trench, or tunnel)

2. Location is: 2 1/2 Miles West of Coburg
(Approximate distance and direction from nearest city or town)

and is more particularly described as follows:

(a) Well bears So. 11° 38' W. 4,636 Feet from the E. 1/4 corner of Sec. 25
(Give distance and bearing to corner of section or other legal subdivision)

being within S.E. 1/4 of N.E. 1/4 of Sec. 36, Twp. 16 S, Rge. 4 W. W.M.
(Smallest legal subdivision) (N. or S.) (E. or W.)

or (b) within limits of recorded platted property, town or city:

in Lot _____, Block _____ of _____
(Name of plat or addition)

County of _____
(If within city or town, give name)

3. Construction Work was begun on June 1951; was completed on June 1951
(Date) (Date)

and the ground water claimed was first used for the purposes set out below on 1951
(Date)

since which time the water has been used Continuously
(Continuously or Intermittently)

from 1951 to 1958
(Date) (Date)

4. Quantity of water claimed and used is 400 gallons per minute; 33.0 acre feet per year.

5. Purpose or Purposes for which water is used Irrigation

(Domestic, irrigation, municipal, manufacturing, industrial, etc.)

6. Description of Well: Depth 8 feet. Type Dug
(Dug or drilled)

diameter 24 inches. Elevation of ground at well site 368 feet, mean sea level.
(As near as known)

Depth to water table 3 feet.

7. Capacity of Well: 800 g.p.m. with 2 feet drawdown.

_____ g.p.m. with _____ feet drawdown.

Date of test August 1955

If Flowing Well: Measured discharge _____ g.p.m. on _____
(Date)

Shut-in pressure at ground surface _____ lbs. per sq. in. on _____
(Date)

Water is controlled by _____
(Cap, valve, etc.)

8. Casing: (Give diameter, commercial specifications and depth below ground surface of each casing size.)

24 inch diameter Galvanized Culvert from 0 to 8 feet

inch diameter from to feet

inch diameter from to feet

inch diameter from to feet

Describe and show depth of shoe, plug, adapter, liner or other details: 5" suction line with a foot valve at a depth of 8 feet.

9. Perforated Casings or Screens:

(Number per foot and size of perforations, or describe screen) from to

from to

from to

from to

10. Log of Well: (Describe each stratum or formation clearly, indicate if water bearing, and give thickness and depth as indicated.)

MATERIAL	Thickness (Feet)	Depth to Bottom (Feet)
Medium sized gravel	6'	6'
Pea gravel	2'	8'

If log of well is not available, give name and address of driller.

11. Infiltration Trench: Covered or open

Dimensions: Length ft. Minimum depth ft. Maximum depth ft.

Bottom width ft. Discharge g.p.m. Date of test

12. Tunnel: Type of lining

Dimensions:
(Length, course, and cross sectional size)

Position of water bearing stratum with reference to portal of tunnel

Log of tunnel: ~~Preceding table for log of well may be used, if desired.~~ (Give footage from portal and character of materials as pertinent.)

13. Pumping Equipment:

(a) Pump 4" x 3" Centrifugal Capacity 400 g.p.m.
(Make, type and size)


(b) Motor 3 Phase, Electric 20 h.p.
(Type and horsepower)

14. Location of area irrigated or to be irrigated, or place of use if for purposes other than irrigation.

Township North or South	Range E. or W. of Willamette Meridian	Section	Forty-acre Tract	Number Acres To Be Irrigated	Date of Reclamation
T.16 S.	R. 4 W.	36	S.W. 1/4 of N.E. 1/4	15	1951
T.16 S.	R. 4 W.	36	S.E. 1/4 of N.E. 1/4	7	
				<u>22</u>	

15. If the ground water supply is supplemental to an existing water supply, identification of any application for a permit, permit, certificate or adjudicated right to appropriate water made or held by the registrant.

Township 16 S Range 4 W, W.M.
North

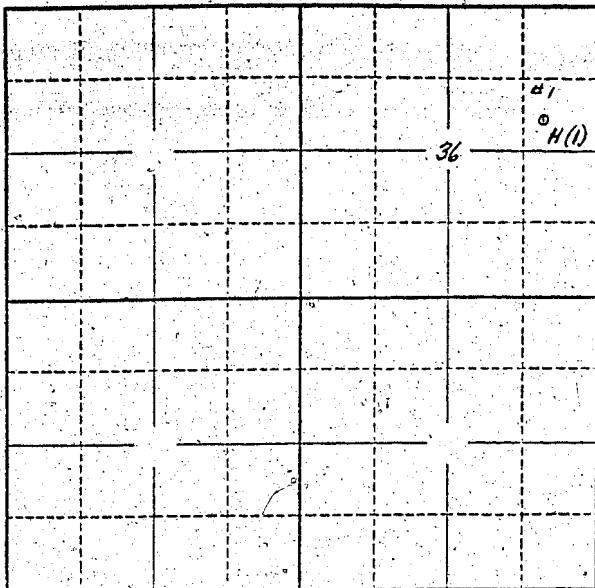

Locate well and acreage of irrigated land on plat.
Scale: 2" = 1 Mile

STATE OF OREGON

County of Lane } ss.

I, Harold Green, being first duly sworn, do hereby certify that I have read the foregoing Registration Statement and that all of the items therein contained are true to the best of my knowledge and belief.

Harold Green
(Signature of Registrant)

Subscribed and sworn to before me this 4 day of July, 1957

My commission expires 7-28-60
Charles J. [unclear]
(Notary Public)

(SEAL)

CERTIFICATE OF REGISTRATION

STATE OF OREGON

County of Marion } ss.

This is to certify that the foregoing Registration Statement was received in the office of the State Engineer on the 7 day of February, 1956, at 10:00 o'clock A. M. and has been duly recorded in said office in Book No. 5 of Registration Statements on page 943

Witness my hand this 7 day of May, 1958

Lewis A. Atkinson
(State Engineer)

By _____ (Deputy)

GR - 943 C