Well # 2

RECEIVED
FEB 10 1958
STATE ENGINEER
SALEM, OREGON

Registration No. GR - 974

Certificate No. GR - 944

Registration Statement

OF CLAIMANT OF RIGHT TO APPROPRIATE GROUND WATER

TO THE STATE ENGINEER OF OREGON:

I, Green Brothers,

of Box 72, Coburg (Mailing address) County of Lane

State of Oregon, do hereby make application for a certificate of registration as evidence of a right to appropriate ground water.

1. **Source** from which water is withdrawn is Pump Well #2 (Flowing well, pump well, infiltration trench, or tunnel)

2. **Location** is: 2 1/2 Miles West of Coburg (Approximate distance and direction from nearest city or town);

and is more particularly described as follows:

(a) Well bears So. 23°01' W. 3,458' from the E. 1/4 corner of Sec. 25 (Give distance and bearing to corner of section or other legal subdivision)

being within N.W.¼ of N.E.¼ (Smallest legal subdivision) of Sec. 36, Twp. 16 S. (N. or S.), Rge. 4 W. (E. or W.)

or (b) within limits of recorded platted property, town or city:

in Lot ....., Block ..... of ..... (Name of plat or addition)

..... (If within city or town, give name) County of .....

3. **Construction Work** was begun on 1954 (Date); was completed on 1954 (Date)

and the ground water claimed was first used for the purposes set out below on 1954 (Date),

since which time the water has been used Continuously (Continuously or intermittently)

from 1954 (Date) to 1958 (Date)

4. **Quantity** of water claimed and used is 400 gallons per minute; 61.5 acre feet per year.

5. **Purpose or Purposes** for which water is used Irrigation

..... (Domestic, irrigation, municipal, manufacturing, industrial, etc.)

6. **Description of Well:** Depth 18 feet. Type Dug (Dug or drilled)

diameter 30 inches. Elevation of ground at well site ~~372~~ 368 (As near as known) feet, mean sea level.

Depth to water table 12 feet.

7. **Capacity of Well:** 400 g.p.m. with 3 feet drawdown.

..... g.p.m. with ..... feet drawdown.

Date of test August 1955

If Flowing Well: Measured discharge ..... g.p.m. on ..... (Date)

Shut-in pressure at ground surface ..... lbs. per sq. in. on ..... (Date)

Water is controlled by ..... (Cap, valve, etc.)

4M—4-57

8. **Casing:** (Give diameter, commercial specifications and depth below ground surface of each casing size.)

..... inch diameter Open hole from 0 to 6 feet

30" inch diameter Concrete well casing from 6 to 18 feet

..... inch diameter ..... from ..... to ..... feet

..... inch diameter ..... from ..... to ..... feet

Describe and show depth of shoe, plug, adapter, liner or other details: 5 inch suction line with a foot valve at a depth of 18 feet.

9. **Perforated Casings or Screens:**

..... from ..... to .....
(Number per foot and size of perforations, or describe screen)

..... from ..... to .....

..... from ..... to .....

..... from ..... to .....

10. **Log of Well:** (Describe each stratum or formation clearly, indicate if water bearing, and give thickness and depth as indicated.)

MATERIAL	Thickness (Feet)	Depth to Bottom (Feet)
Medium sized gravel	16'	16'
Pea gravel	2'	18'

GR-944 A

If log of well is not available, give name and address of driller. .....

.....

11. **Infiltration Trench:** Covered or open .....

Dimensions: Length ..... ft. Minimum depth ..... ft. Maximum depth ..... ft.

Bottom width ..... ft. Discharge ..... g.p.m. Date of test .....

12. **Tunnel:** Type of lining .....

Dimensions: .....
(Length, course, and cross sectional size)

Position of water bearing stratum with reference to portal of tunnel .....

.....

Log of tunnel: (Preceding table for log of well may be used, if desired. Give footage from portal and character of materials, as pertinent.)

13. **Pumping Equipment:**

(a) Pump 4" X 3" Centrifugal (Make, type and size) Capacity 400 g.p.m.

(b) Motor 3 Phase, Electric 20 h.p. (Type and horsepower)

14. Location of area irrigated or to be irrigated, or place of use if for purposes other than irrigation.

Township North or South	Range E. or W. of Willamette Meridian	Section	Forty-acre Tract	Number Acres To Be Irrigated	Date of Reclamation
T. 16 S.	R. 4 W.	36	N.W.¼ of N.E.¼	25	1954
T. 16 S.	R. 4 W.	36	N.E.¼ of N.E.¼	9.5	"
T. 16 S.	R. 4 W.	36	S.E.¼ of N.E.¼	3	
T. 16 S.	R. 4 W.	25	S.W.¼ of S.E.¼	6.5	
				44.0	

15. If the ground water supply is supplemental to an existing water supply, identification of any application for a permit, permit, certificate or adjudicated right to appropriate water made or held by the registrant.

.....

.....

Township 16 S Range R4W, W.M.

North

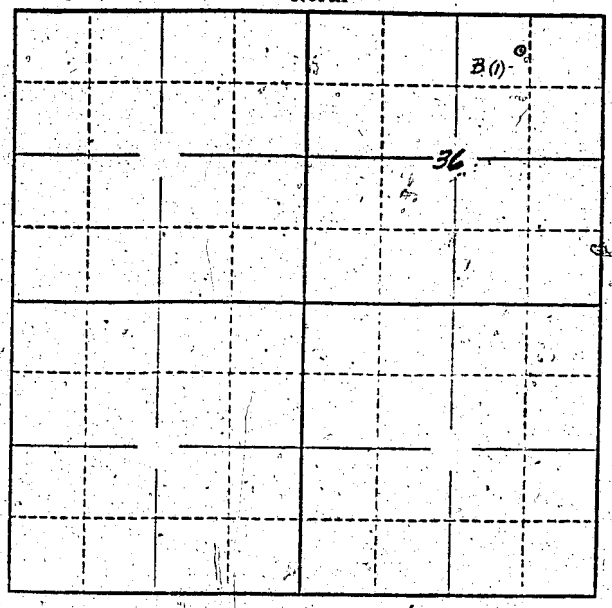

Locate well and acreage of irrigated land on plat.

Scale: 2" — 1 Mile

STATE OF OREGON
County of Lane } ss.

I, Harold Green, being first duly sworn, do hereby certify that I have read the foregoing Registration Statement and that all of the items therein contained are true to the best of my knowledge and belief.

(Signature of Registrant)

Subscribed and sworn to before me this 4 day of July, 1958

My commission expires 7-28-60

(Notary Public)

(SEAL)

CERTIFICATE OF REGISTRATION

STATE OF OREGON
County of Marion } ss.

This is to certify that the foregoing Registration Statement was received in the office of the State Engineer on the 7 day of February, 1958, at 10:00 o'clock A. M. and has been duly recorded in said office in Book No. 5 of Registration Statements on page 944.

Witness my hand this 7 day of May, 1958.

Lewis A. Stone
(State Engineer)

By
(Deputy)

GR-944 C