

Well # 3

Registration No. GR - 975

Certificate No. GR - 945

STATE ENGINEER  
SALEM, OREGON

# Registration Statement

## OF CLAIMANT OF RIGHT TO APPROPRIATE GROUND WATER

TO THE STATE ENGINEER OF OREGON:

I, Green Brothers

of Box 72, Coburg County of Lane

(Mailing address)

State of Oregon do hereby make application for a certificate of registration as evidence of a right to appropriate ground water.

1. Source from which water is withdrawn is Pump Well # 3  
(Flowing well, pump well, infiltration trench, or tunnel)

2. Location is: 2 1/2 miles west of Coburg  
(Approximate distance and direction from nearest city or town)

and is more particularly described as follows:

(a) Well bears So. 37°15' W. 2448 feet from the E. 1/4 corner of Sec. 25  
(Give distance and bearing to corner of section or other legal subdivision)

being within S.W. 1/4 of S.E. 1/4 of Sec. 25, Twp. T. 16 S., Rge. R. 4 W.  
(Smallest legal subdivision) (N. or S.) (E. or W.)

or (b) within limits of recorded platted property, town, or city:

in Lot \_\_\_\_\_, Block \_\_\_\_\_ of \_\_\_\_\_  
(Name of plat or addition)

County of \_\_\_\_\_  
(If within city or town, give name)

3. Construction Work was begun on June 1951; was completed on June 1951  
(Date) (Date)

and the ground water claimed was first used for the purposes set out below on 1951  
(Date)

since which time the water has been used CONTINUOUSLY  
(Continuously or intermittently)

from 1951 to 1958  
(Date) (Date)

4. Quantity of water claimed and used is 400 gallons per minute: 79.5 acre feet per year.

5. Purpose or Purposes for which water is used Irrigation

(Domestic, irrigation, municipal, manufacturing, industrial, etc.)

6. Description of Well: Depth 18 feet. Type Dug  
(Dug or drilled)

diameter 24 inches. Elevation of ground at well site 368 feet, mean sea level.  
(As near as known)

Depth to water table 6 feet.

7. Capacity of Well: 400 g.p.m. with 5 feet drawdown.

g.p.m. with \_\_\_\_\_ feet drawdown.

Date of test August 1955

If Flowing Well: Measured discharge \_\_\_\_\_ g.p.m. on \_\_\_\_\_  
(Date)


Shut-in pressure at ground surface \_\_\_\_\_ lbs. per sq. in. on \_\_\_\_\_  
(Date)

Water is controlled by \_\_\_\_\_  
(Cap. valve, etc.)





Township 16 S Range 4 W, W.M.  
North

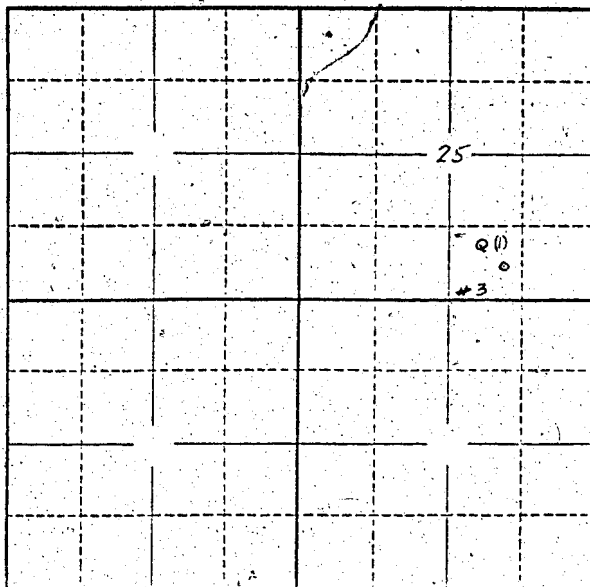

Locate well and acreage of irrigated land on plat.

Scale: 2" = 1 Mile

STATE OF OREGON

County of Lane } ss.

I, Harold Green, being first duly sworn, do hereby certify that I have read the foregoing Registration Statement and that all of the items therein contained are true to the best of my knowledge and belief.

Subscribed and sworn to before me this 4 day of July, 1958

My commission expires 7-24-60

(Signature of Registrant)

[Signature]  
(Notary Public)

(SEAL)

**CERTIFICATE OF REGISTRATION**

STATE OF OREGON

County of Marion } ss.

This is to certify that the foregoing Registration Statement was received in the office of the State Engineer on the 7 day of February, 1958, at 10:00 o'clock A.M. and has been duly recorded in said office in Book No. 5 of Registration Statements on page 915.

Witness my hand this 7 day of May, 1958

[Signature]  
(State Engineer)

By \_\_\_\_\_ (Deputy)

GR - 945 C