

RECEIVED
FEB 10 1953
STATE ENGINEER
SALEM, OREGON

Registration No. GR - 983

Certificate No. GR - 952

Registration Statement

OF CLAIMANT OF RIGHT TO APPROPRIATE GROUND WATER

TO THE STATE ENGINEER OF OREGON:

I, Gilbert Knips

of 491 Oak Grove Road, Medford County of Jackson
(Mailing address)

State of Oregon, do hereby make application for a certificate of registration as evidence of a right to appropriate ground water.

1. Source from which water is withdrawn is #2 Sump
(Flowing well, pump well, infiltration trench, or tunnel)

2. Location is: 2 miles west and South of Medford, Oregon
(Approximate distance and direction from nearest city or town)

and is more particularly described as follows:

(a) 90 feet North and 335 feet East from the NW corner DIC #77
(Give distance and bearing to corner of section or other legal subdivision)

being within SE 1 SW 1 of Sec. 26, Twp. 37 S., Rge. 2 W.
(Smallest legal subdivision) (N. or S.) (E. or W.)

or (b) within limits of recorded platted property, town or city:

in Lot _____, Block _____ of _____
(Name of plat or addition)

(If within city or town, give name) County of _____

3. Construction Work was begun on 1953; was completed on 1957
(Date) (Date)

and the ground water claimed was first used for the purposes set out below on 1953
(Date)

since which time the water has been used intermittently
(Continuously or Intermittently)

from 1953 to October 1957
(Date) (Date)

4. Quantity of water claimed and used is 80 gallons per minute; 108 acre feet per year.

5. Purpose or Purposes for which water is used supplemental irrigation

(Domestic, irrigation, municipal, manufacturing, industrial, etc.)

See Item 116. Description of Well: Depth 10 feet. Type drilled
(Dug or drilled)

diameter 12 1/2 x 5 1/2. Elevation of ground at well site 1135 feet, mean sea level.
(As near as known)

Depth to water table 1.0 feet.

7. Capacity of Well: _____ g.p.m. with _____ feet drawdown.

_____ g.p.m. with _____ feet drawdown.


Date of test none

If Flowing Well: Measured discharge _____ g.p.m. on _____
(Date)

Shut-in pressure at ground surface _____ lbs. per sq. in. on _____
(Date)

Water is controlled by _____
(Cap, valve, etc.)

Township 37 S Range 2W, W.M.
North

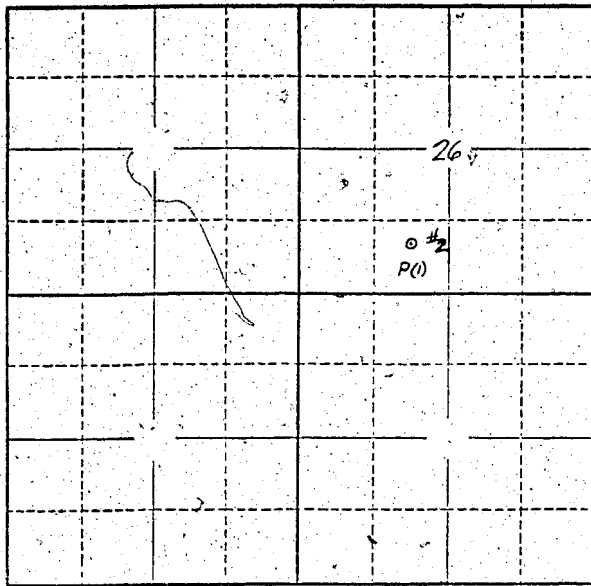

Locate well and acreage of irrigated land on plat.
Scale: 2" = 1 Mile

STATE OF OREGON

County of Jackson } ss.

I, Gilbert G. Knips, being first duly sworn, do hereby certify that I have read the foregoing Registration Statement and that all of the items therein contained are true to the best of my knowledge and belief.

[Signature]
(Signature of Registrant)

Subscribed and sworn to before me this 7th day of February, 1958

My commission expires August 25, 1958
(Notary Public)

(SEAL)

CERTIFICATE OF REGISTRATION

STATE OF OREGON } ss.
County of Marion

This is to certify that the foregoing Registration Statement was received in the office of the State Engineer on the 10th day of February, 1958, at o'clock M. and has been duly recorded in said office in Book No. 5 of Registration Statements on page 952

Witness my hand this 7 day of May, 1958

[Signature: Lewis A. Stanley]
(State Engineer)

By
(Deputy)