

RECEIVED
FEB 10 1958
STATE ENGINEER
ALLEN G. HOGAN

Registration Statement

REGISTRATION NO. GR-988

CERTIFICATE NO. GR-957

OF CLAIMANT OF RIGHT TO APPROPRIATE GROUND WATER

(Under Chapter 708, Oregon Laws 1955.)

TO THE STATE ENGINEER OF OREGON:

I, John Niedermeyer

of Route 2, Box 464, Medford, County of Jackson

State of Oregon, do hereby make application for a certificate of registration as evidence of a right to appropriate ground water.

1. Source from which water is withdrawn is Infiltration Trench (Sump)
(Flowing well, pump well, infiltration trench, or tunnel)

2. Location is: 5 miles West of Medford or 1 1/2 miles North of Jacksonville,
(Approximate distance and direction from nearest city or town)

and is more particularly described as follows:

(a) 770' S. and 1035' E. from the Inside Ell Corner DLC #40
(Give distance and bearing to corner of section or other legal subdivision)

being within SE 1/4 SE 1/4 of Sec. 20, Twp. 37 S., Rge. 2 W.
(Smallest legal subdivision) (N. or S.) (E. or W.)

or (b) within limits of recorded platted property, town or city:

in Lot _____ Block _____ of _____
(Name of plat or addition)

County of _____
(If within city or town, give name)

3. Construction Work was begun on Sept., 1951; was completed on July 1952
(Date) (Date)

and the ground water claimed was first used for the purposes set out below on April, 1952
(Date)

since which time the water has been used Intermittently
(Continuously or intermittently)

from April 1952 to October, 1957.
(Date) (Date)

4. Quantity of water claimed and used is 170 gallons per minute; 68 acre
feet per year.

5. Purpose or Purposes for which water is used Irrigation

(Domestic, irrigation, municipal, manufacturing, industrial, etc.)

See Item 6. Description of Well: Depth 15 feet. Type Dug
(Dug or drilled)

diameter 40" x 300". Elevation of ground at well site 1,170 feet, mean sea level.
(As near as known)

Depth to water table 2.0 feet.

7. Capacity of Well: _____ g.p.m. with _____ feet drawdown.

_____ g.p.m. with _____ feet drawdown.

Date of test, none

If Flowing Well: Measured discharge _____ g.p.m. on _____
(Date)

Shot-in pressure at ground surface _____ lbs. per sq. in. on _____
(Date)

Water is controlled by _____
(Cap, valve, etc.)

8. **Casing:** (Give diameter, commercial specifications and depth below ground surface of each casing size.)

..... inch diameter	None from to feet
..... inch diameter	 from to feet
..... inch diameter	 from to feet
..... inch diameter	 from to feet

Describe and show depth of shoe, plug, adapter, liner or other details:

9. **Perforated Casings or Screens:**

.....	None from to
<small>(Number per foot and size of perforations, or describe screen)</small>			
.....	 from to
.....	 from to
.....	 from to

10. **Log of Well:** (Describe each stratum or formation clearly, indicate if water bearing, and give thickness and depth as indicated.)

MATERIAL	Thickness (Feet)	Depth to Bottom (Feet)
Brown Clay	11	11
Light Brown Clay with decomposed granite (water bearing)	11	0

If log of well is not available, give name and address of driller.

11. Infiltration Trench: Covered or open open
Dimensions: Length 300 ft. Minimum depth 10 ft. Maximum depth 15 ft.

Bottom width 35 ft. Discharge g.p.m. Date of test none

12. Tunnel: Type of lining

Dimensions:
(Length, course, and cross sectional size)

Position of water bearing stratum with reference to portal of tunnel

Log of tunnel: (Preceding table for log of well may be used, if desired. Give footage from portal and character of materials, as pertinent.)

13. Pumping Equipment:

(a) Pump 2.5 inch centrifugal pump Capacity g.p.m.
(Make, type and size)

(b) Motor 7.5 H.P. electric motor
(Type and horsepower)


14. Location of area irrigated or to be irrigated, or place of use if for purposes other than irrigation.

Township North or South	Range E. or W. of Willamette Meridian	Section	Forty-acre Tract	Number Acres To Be Irrigated	Date of Reclamation
37 S.	2 W.	21	SW $\frac{1}{4}$ SW $\frac{1}{4}$	15 acres	April 1952

15. If the ground water supply is supplemental to an existing water supply, identification of any application for a permit, permit, certificate or adjudicated right to appropriate water made or held by the registrant.

None

Township 37.5 Range 2 W, W.M.

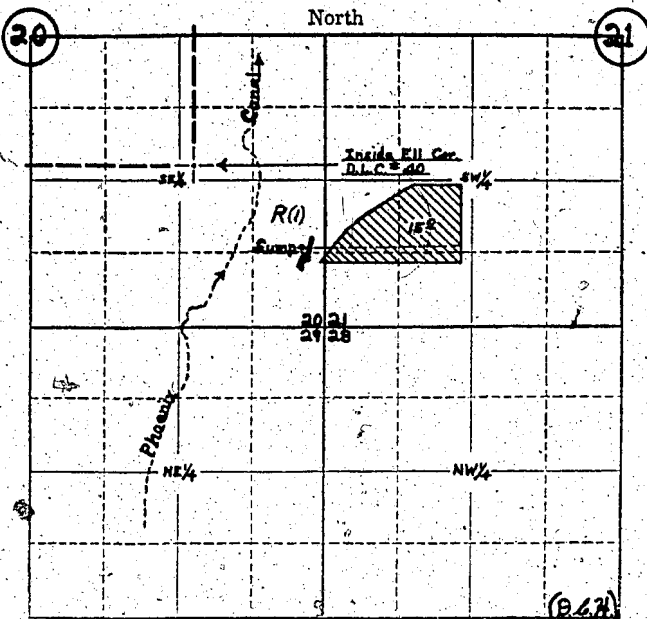

Locate well and acreage of irrigated land on plat.

Scale: 4" = 1 Mile

STATE OF OREGON

County of Marion

I, [Signature] being first duly sworn, do hereby certify that I have read the foregoing Registration Statement and that all of the items therein contained are true to the best of my knowledge and belief.

(Signature of Registrant)

Subscribed and sworn to before me this 7th day of February, 1958

My commission expires 2/3/61

(Notary Public)

(SEAL)

CERTIFICATE OF REGISTRATION

STATE OF OREGON

County of Marion

This is to certify that the foregoing Registration Statement was received in the office of the State Engineer on the 10th day of February, 1958, at 5 o'clock A.M. and has been duly recorded in said office in Book No. 5 of Registration Statements on page 957.

Construction shall be completed by [unclear] and the water completely applied to beneficial use by [unclear].

Witness my hand this 28th day of May, 1958

(State Engineer)

By

(Deputy)

GR-957C