

RECEIVED  
1956  
STATE ENGINEER  
SANEEN OREGON

REGISTRATION NO. GR-99

CERTIFICATE NO. GR-150

# Registration Statement

## OF CLAIMANT OF RIGHT TO APPROPRIATE GROUND WATER

(Under Chapter 703, Oregon Laws 1955.)

TO THE STATE ENGINEER OF OREGON:

I, Herman and Lena Krussi

of Rt. 1, Brownsville County of Linn

State of \_\_\_\_\_, do hereby make application for a certificate of registration as evidence of a right to appropriate ground water.

1. Source from which water is withdrawn is pump well  
(Flowing well, pump well, infiltration trench, or tunnel)

2. Location is: 1/4 mile south of Brownsville, Oregon  
(Approximate distance and direction from nearest city or town)

and is more particularly described as follows:

(a) 1386' N and 1122' E. of the SW corner of S. 6, T. 14 S., R. 2 W., M.  
(Give distance and bearing to corner of section or other legal subdivision)

being within SW 1/4 of NE 1/4 of Sec. 6, Twp. 14 S, Rge. 2 W.  
(Smallest legal subdivision) (N. or S.) (E. or W.)

or (b) within limits of recorded platted property, town or city:

in Lot \_\_\_\_\_, Block \_\_\_\_\_ of \_\_\_\_\_  
(Name of plat or addition)

County of Linn  
(If within city or town, give name)

3. Construction Work was begun on May 10, 1948; was completed on May 15, 1952  
(Date) (Date)

and the ground water claimed was first used for the purposes set out below on Sept. 10, 1949  
(Date)

since which time the water has been used continuously  
(Continuously or Intermittently)

from Sept. 10, 1949 to present time  
(Date) (Date)

4. Quantity of water claimed and used is 100 gallons per minute; 60 acre feet per year.

5. Purpose or Purposes for which water is used Irrigation

(Domestic, irrigation, municipal, manufacturing, industrial, etc.)

6. Description of Well: Depth 83 feet. Type drilled  
(Dug or drilled)

diameter 8 inches. Elevation of ground at well site 320 feet, mean sea level.  
(As near as known)

Depth to water table 6 feet. in spring, about 8 ft in August or September.

7. Capacity of Well: 150 g.p.m. with 65 feet drawdown.

\_\_\_\_\_ g.p.m. with \_\_\_\_\_ feet drawdown.

Date of test: Estimated

If Flowing Well: Measured discharge \_\_\_\_\_ g.p.m. on \_\_\_\_\_  
(Date)

Shut-in pressure at ground surface \_\_\_\_\_ lbs. per sq. in. on \_\_\_\_\_  
(Date)

Water is controlled by \_\_\_\_\_  
(Cap, valve, etc.)

8. Casing: (Give diameter, commercial specifications and depth below ground surface of each casing size.)

8 inch diameter ..... steel casing ..... from 0 to 80 feet  
..... inch diameter ..... from ..... to ..... feet  
..... inch diameter ..... from ..... to ..... feet  
..... inch diameter ..... from ..... to ..... feet

Describe and show depth of shoe, plug, adapter, liner or other details: .....

9. Perforated Casings or Screens:

Slit perforations

(Number per foot and size of perforations, or describe screen)

from 20 to 25

" "

from 50 to 55

" "

from 75 to 80

from ..... to .....

10. Log of Well: (Describe each stratum or formation clearly, indicate if water bearing, and give thickness and depth as indicated.)

MATERIAL	Thickness (Feet)	Depth to Bottom (Feet)
Clay	10	10
Blue clay	10	20
Sand & gravel	5	25
Blue clay	25	50
Hard pan	30	80
Note: Log from memory		

If log of well is not available, give name and address of driller. \_\_\_\_\_

11. Infiltration Trench: Covered or open \_\_\_\_\_  
 Dimensions: Length \_\_\_\_\_ ft. Minimum depth \_\_\_\_\_ ft. Maximum depth \_\_\_\_\_ ft.  
 Bottom width \_\_\_\_\_ ft. Discharge \_\_\_\_\_ g.p.m. Date of test \_\_\_\_\_

12. Tunnel: Type of lining \_\_\_\_\_  
 Dimensions: \_\_\_\_\_  
(Length, course, and cross sectional size)  
 Position of water bearing stratum with reference to portal of tunnel \_\_\_\_\_

Log of tunnel: (Preceding table for log of well may be used, if desired. Give footage from portal and character of materials, as pertinent.)


13. Pumping Equipment:  
 (a) Pump Fairbanks Morse Turbine Capacity 300 g.p.m.  
(Make, type and size)  
 (b) Motor 10 H. P. electric motor  
(Type and horsepower)

14. Location of area irrigated or to be irrigated, or place of use if for purposes other than irrigation.

Township North or South	Range E. or W. of Willamette Meridian	Section	Forty-acre Tract	Number Acres To Be Irrigated	Date of Reclamation
14 S	2 W	6	SW $\frac{1}{4}$ of NW $\frac{1}{4}$	7.4	Sept. 10, 1949
14 S	2 W	6	NW $\frac{1}{4}$ of SW $\frac{1}{4}$	3.0	" "
14 S	2 W	6	SE $\frac{1}{4}$ of NW $\frac{1}{4}$	6.7	" "
14 S	2 W	6	NW $\frac{1}{4}$ of SW $\frac{1}{4}$	8.2	" "
				25.3	

15. If the ground water supply is supplemental to an existing water supply, identification of any application for a permit, permit, certificate or adjudicated right to appropriate water made or held by the registrant. \_\_\_\_\_

Township 145 Range 2 W., W.M.  
North

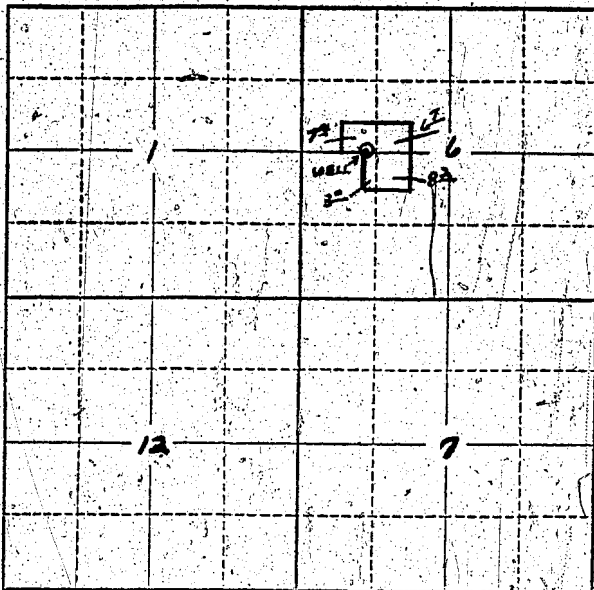

Locate well and acreage of irrigated land on plat.

Scale: 2" = 1 Mile

STATE OF OREGON

County of Tillamook } ss.

I, Herman and Lena Krusi, being first duly sworn, do hereby certify that I have read the foregoing Registration Statement and that all of the items therein contained are true to the best of my knowledge and belief.

Herman Krusi

Lena Krusi  
(Signature of Registrant)

Subscribed and sworn to before me this 31st day of January, 1956

My commission expires Aug 4, 1957

Satanalee Street  
(Notary Public)

(SEAL)

**CERTIFICATE OF REGISTRATION**

STATE OF OREGON

County of Marion } ss.

This is to certify that the foregoing Registration Statement was received in the office of the State Engineer on the 2nd day of February, 1956, at 8 o'clock AM and has been duly recorded in said office in Book No. 1 of Registration Statements on page GR-130 C.

Construction shall be completed by October 19, 1956 and the water completely applied to beneficial use by October 19, 1956.

Witness my hand this 8th day of October, 1956

Lewis A. Stanley  
(State Engineer)

By \_\_\_\_\_  
(Deputy)