

Registration No. GR - 990

Certificate, No. GR - 959

Registration Statement

OF CLAIMANT OF RIGHT TO APPROPRIATE GROUND WATER.

TO THE STATE ENGINEER OF OREGON:

I, Henry I. Bahrner
of R 5 Box 756 Salem County of Marion
State of Oregon, do hereby make application for a certificate of registration as evidence of a right to appropriate ground water.

1. Source from which water is withdrawn is Pump well
(Flowing well, pump well, infiltration trench, or tunnel)
2. Location is: 6 miles East of Salem
(Approximate distance and direction from nearest city or town)

and is more particularly described as follows:

- (a) 2300 feet east & 600 feet north from Sec. corner Section 27
(Give distance and bearing to corner of section or other legal subdivision)
being within SE 1/4 of Sub 4 of Sec. 27 Twp. 7 S Rge. 7 W
(Smallest legal subdivision) (N. or S.) (E. or W.)
- or (b) within limits of recorded platted property, town or city:

in Lot _____, Block _____ of _____
(Name of plat or addition)
County of _____
(If within city or town, give name)

3. Construction Work was begun on Oct 1951; was completed on Oct 1951
(Date) (Date)
and the ground water claimed was first used for the purposes set out below on Summer 1952
(Date)
since which time the water has been used Intermittently
(Continuously or intermittently)
from June through September
(Date) (Date)

4. Quantity of water claimed and used is 110 gallons per minute; _____ acre feet per year.

5. Purpose or Purposes for which water is used Pasture and alfalfa
(Domestic, irrigation, municipal, manufacturing, industrial, etc.)

6. Description of Well: Depth 100 feet. Type Drilled
(Dug or drilled)
diameter 8 inches. Elevation of ground at well site 200 feet, mean sea level.
(As near as known)
Depth to water table No not know. feet.

7. Capacity of Well: 110 g.p.m. with _____ feet drawdown.
_____ g.p.m. with _____ feet drawdown.

Date of test Oct 1951
If Flowing Well: Measured discharge _____ g.p.m. on _____
(Date)
Shut-in pressure at ground surface _____ lbs. per sq. in. on _____
(Date)
Water is controlled by Valve
(Cap, valve, etc.)

size.)

8 inch diameter from 0 to 100 feet

..... inch diameter from to feet

..... inch diameter from to feet

_____ inch diameter _____ from _____ to _____ feet

Describe and show depth of shoe, plug, adapter, liner or other details: _____

9. Perforated Casings or Screens:

Parfano James

15 ft. x 12 ft. x 12 ft. from to
(Number per foot and size of perforations, or describe screen)

..... from to

..... from to

..... from to

10. Log of Well: (Describe each stratum or formation clearly, indicate if water bearing, and give thickness and depth as indicated.)

[illegible]

11. Infiltration Trench: Covered or open

Dimensions: Length ft. Minimum depth ft. Maximum depth ft.

Bottom width ft. Discharge g.p.m. Date of test

12. Tunnel: Type of lining

Dimensions:

(Length, course, and cross sectional size)

Position of water bearing stratum with reference to portal of tunnel

Log of tunnel: (Preceding table for log of well may be used, if desired. Give footage from portal and character of materials, as pertinent.)

13. Pumping Equipment:

(a) Pump Gas turbine Capacity 110 g.p.m.

(Make, type and size)

(b) Motor 1/2 3 PH motor


(Type and horsepower)

14. Location of area irrigated or to be irrigated, or place of use if for purposes other than irrigation.

[illegible]

15. If the ground water supply is supplemental to an existing water supply, identification of any application for a permit, permit, certificate or adjudicated right to appropriate water made or held by the registrant.

Township 7S Range 2W, W.M.
North

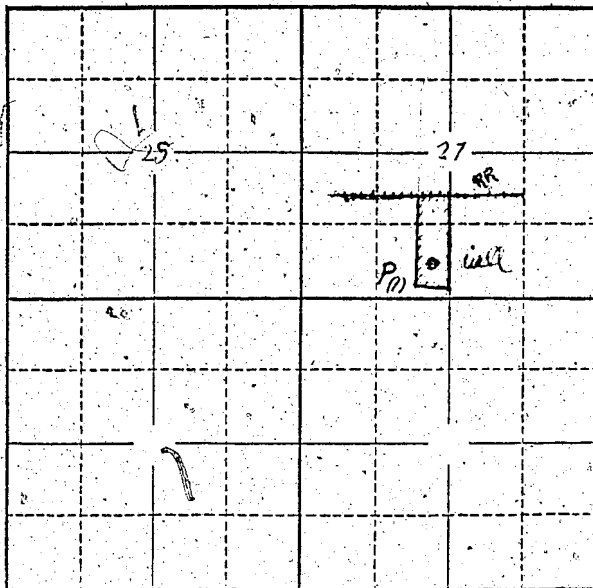

Locate well and acreage of irrigated land on plat.

Scale: 2" = 1 Mile

STATE OF OREGON

County of Marion

ss.

I, _____, being first duly sworn, do hereby certify that I have read the foregoing Registration Statement and that all of the items therein contained are true to the best of my knowledge and belief.

Henry L. Bahnsen

(Signature of Registrant)

Subscribed and sworn to before me this 10th day of February, 1958

My commission expires 12th June 1961

Wm. S. Bartholomew

(Notary Public)

(SEAL)

CERTIFICATE OF REGISTRATION

STATE OF OREGON

County of Marion

ss.

This is to certify that the foregoing Registration Statement was received in the office of the State Engineer on the 10 day of February, 1958, at 8:00 o'clock AM and has been duly recorded in said office in Book No. 5 of Registration Statements on page 959.

Witness my hand this 28 day of May, 1958

Leura A. Stanley

(State Engineer)

By _____

(Deputy)