RECEIVED
FEB 21 1958
STATE ENGINEER
SALEM, OREGON

REGISTRATION NO. GR-991
CERTIFICATE NO. GR-960

Registration Statement

OF CLAIMANT OF RIGHT TO APPROPRIATE GROUND WATER

(Under Chapter 708, Oregon Laws 1955.)

TO THE STATE ENGINEER OF OREGON:

I, Peter Parvin,

of Amity, Route 1 Box 216 County of Yamhill

State of Oregon, do hereby make application for a certificate of registration as evidence of a right to appropriate ground water.

1. **Source** from which water is withdrawn is pump well (Flowing well, pump well, infiltration trench, or tunnel)

2. **Location** is: 3½ miles east of Amity (Approximate distance and direction from nearest city or town);

and is more particularly described as follows:

(a) 1920 feet south & 500 feet east from N¼ corner Section 25 (Give distance and bearing to corner of section or other legal subdivision)

being within SW¼ of NE¼ (Smallest legal subdivision) of Sec. 25, Twp. 5S (N. or S.), Rge. 4W (E. or W.)

or (b) within limits of recorded platted property, town or city:

in Lot 6A, Block ..... of Willamette Gardens recorded February 6, 1913 Book 4, Page 17 (Name of plat or addition)

..... (If within city or town, give name) County of Yamhill

3. **Construction Work** was begun on summer 1954 (Date); was completed on Fall of 1954 (Date)

and the ground water claimed was first used for the purposes set out below on summer 1955 (Date),

since which time the water has been used continuously (Continuously or intermittently)

from 1955 (Date) to present (Date)

4. **Quantity** of water claimed and used is 75 gallons per minute; average 5 to 9 acre feet per year.

5. **Purpose or Purposes** for which water is used irrigation and orchard sprays

..... (Domestic, irrigation, municipal, manufacturing, industrial, etc.)

6. **Description of Well:** Depth 268 feet. Type drilled and cased (Dug or drilled)

diameter 10 inches. Elevation of ground at well site aprox ~~550~~ 450 (As near as known) feet, mean sea level.

Depth to water table 225 feet. in summer

7. **Capacity of Well:** 75 g.p.m. with about 30 feet drawdown.

..... g.p.m. with ..... feet drawdown.

Date of test Fall of 1954 and spring of 1955

If Flowing Well: Measured discharge ..... g.p.m. on ..... (Date)

Shut-in pressure at ground surface ..... lbs. per sq. in. on ..... (Date)

Water is controlled by ..... (Cap, valve, etc.)

8. **Casing:** (Give diameter, commercial specifications and depth below ground surface of each casing size.)

6 inch diameter steel casing from 0 to 50 then solid rock feet

inch diameter from to feet

inch diameter from to feet

inch diameter from to feet

Describe and show depth of shoe, plug, adapter, liner or other details:

9. **Perforated Casings or Screens:**

none (Number per foot and size of perforations, or describe screen) from to

from to

from to

from to

10. **Log of Well:** (Describe each stratum or formation clearly, indicate if water bearing, and give thickness and depth as indicated.)

MATERIAL	Thickness (Feet)	Depth to Bottom (Feet)
Soil	5	5
Clay and shale	45	50
Solid rock	218	268

GR-960 A

If log of well is not available, give name and address of driller. Miller

11. **Infiltration Trench:** Covered or open .....

Dimensions: Length ..... ft. Minimum depth ..... ft. Maximum depth ..... ft.

Bottom width ..... ft. Discharge ..... g.p.m. Date of test .....

12. **Tunnel:** Type of lining .....

Dimensions: .....
(Length, course, and cross sectional size)

Position of water bearing stratum with reference to portal of tunnel .....

Log of tunnel: (Preceding table for log of well may be used, if desired. Give footage from portal and character of materials, as pertinent.)

13. **Pumping Equipment:**

(a) Pump Submerged turbine (Make, type and size) Capacity 100 g.p.m.

(b) Motor 15 horsepower (Type and horsepower)

14. Location of area irrigated or to be irrigated, or place of use if for purposes other than irrigation.

Township North or South	Range E. or W. of Willamette Meridian	Section	Forty-acre Tract	Number Acres To Be Irrigated	Date of Reclamation
5 S	4 W	25	SW¼ of NE¼ Plot 61 -Willamette Gardens	6	1914
"	"	"	SW¼ of NE¼ " 64 "	3	1914
"	"	"	SE¼ of NW¼ " 231 Eola Walnut Groves	1	1914
"	"	"	SE¼ of NW¼ " 232 " "	½	1914
				10.5 Acres	

15. If the ground water supply is supplemental to an existing water supply, identification of any application for a permit, permit, certificate or adjudicated right to appropriate water made or held by the registrant.

.....

.....

GR- 960 B

Township 5S Range 4W, W.M.

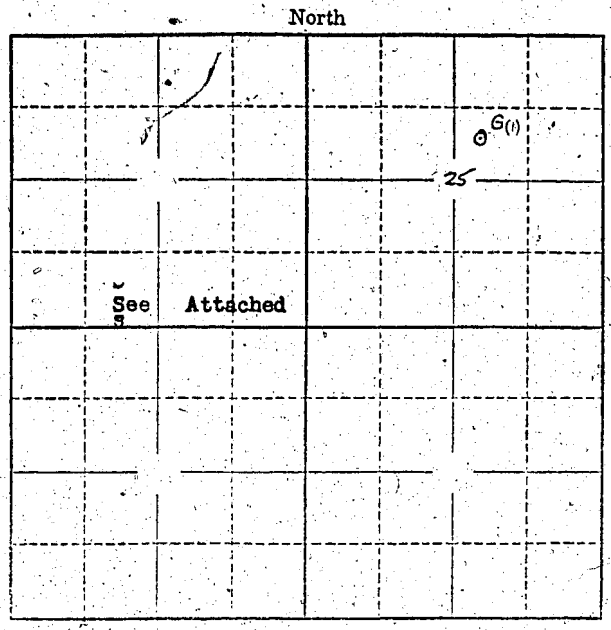

Locate well and acreage of irrigated land on plat.

Scale: 2" = 1 Mile

STATE OF OREGON
County of Yamhill } ss.

I, Peter Parvin, being first duly sworn, do hereby certify that I have read the foregoing Registration Statement and that all of the items therein contained are true to the best of my knowledge and belief.

Peter Parvin
(Signature of Registrant)

Subscribed and sworn to before me this 6th day of February, 19 58

My commission expires MY COMMISSION [illegible]

[illegible]
(Notary Public)

(SEAL)

CERTIFICATE OF REGISTRATION

STATE OF OREGON
County of Marion } ss.

This is to certify that the foregoing Registration Statement was received in the office of the State Engineer on the 11 day of February, 19 58, at 2:00 o'clock A M. and has been duly recorded in said office in Book No. 5 of Registration Statements on page 960.

~~Construction shall be completed by X-X-X-X-X-X-X-X-X-X-X-19 X-X, and the water completely applied to beneficial use by X-X-X-X-X-X-X-X-X-X-X-19 X-X~~

Witness my hand this 28 day of May, 1958

Lewis A. Stanley
(State Engineer)

By
(Deputy)

GR- 960 C