

# Registration Statement

## OF CLAIMANT OF RIGHT TO APPROPRIATE GROUND WATER

### TO THE STATE ENGINEER OF OREGON:

I, Kenneth W. and Kenneth R. Beebe

of Box 523, Beebe Road, Central Point, County of Jackson

(Mailing address)

State of Oregon, do hereby make application for a certificate of registration as evidence of a right to appropriate ground water.

1. Source from which water is withdrawn is Infiltration Trench (Sump)  
(Flowing well, pump well, infiltration trench, or tunnel)

2. Location is: 1/2 mile East and North of Central Point, Oregon  
(Approximate distance and direction from nearest city or town)

and is more particularly described as follows:

(a) 925 feet North and 1670 feet East from the SW corner DIC #55  
(Give distance and bearing to corner of section or other legal subdivision)

being within NE 1/4 NE 1/4 SW 1/4 of Sec. 2, Twp. 37 S., Rge. 2 W.  
(Smallest legal subdivision) (N. or S.) (E. or W.)

or (b) within limits of recorded platted property, town or city:

in Lot \_\_\_\_\_, Block \_\_\_\_\_ of \_\_\_\_\_  
(Name of plat or addition)

County of \_\_\_\_\_  
(If within city or town, give name)

3. Construction Work was begun on October 1954; was completed on October 1954  
(Date) (Date)

and the ground water claimed was first used for the purposes set out below on April 1955  
(Date)

since which time the water has been used continuously  
(Continuously or intermittently)

from April 1955 to October 1957  
(Date) (Date)

4. Quantity of water claimed and used is 200 gallons per minute; 102 acre feet per year.

5. Purpose or Purposes for which water is used irrigation

(Domestic, irrigation, municipal, manufacturing, industrial, etc.)

See Item 11

6. Description of Well: Depth 14 feet. Type Dug  
(Dug or drilled)

diameter 40' x 100' Elevation of ground at well site 1250 feet, mean sea level.  
(As near as known)

Depth to water table 3.0 feet.

7. Capacity of Well: 280 g.p.m. with 8.0 feet drawdown.

\_\_\_\_\_ g.p.m. with \_\_\_\_\_ feet drawdown.

Date of test none - noted from use.

If Flowing Well: Measured discharge \_\_\_\_\_ g.p.m. on \_\_\_\_\_  
(Date)


Shut-in pressure at ground surface \_\_\_\_\_ lbs. per sq. in. on \_\_\_\_\_  
(Date)

Water is controlled by \_\_\_\_\_  
(Cap, valve, etc.)





Township 37 S. Range 2 W. W.M.  
North

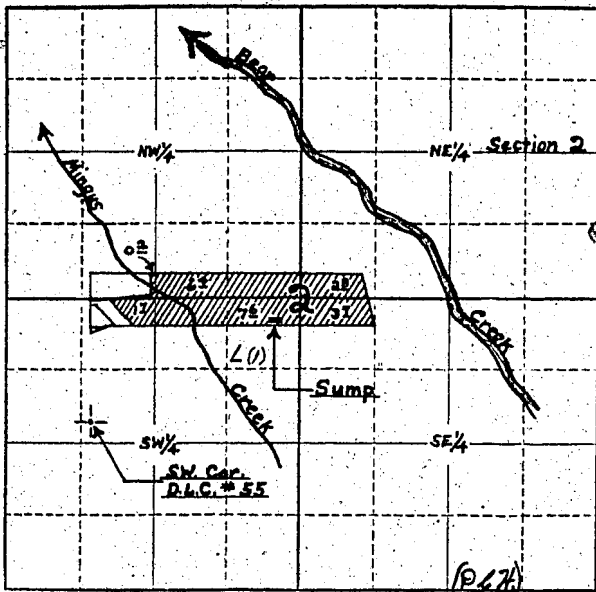

Locate well and acreage of irrigated land on plat.  
Scale: 4" = 1 Mile

STATE OF OREGON

County of Jackson

ss.

Beebe

I, Kenneth R. Beebe and I, Kenneth W. Beebe, being first duly sworn, do hereby certify that I have read the foregoing Registration Statement and that all of the items therein contained are true to the best of my knowledge and belief.

*[Handwritten Signature]*  
\_\_\_\_\_  
(Signature of Registrant)

Subscribed and sworn to before me this 10th day of February, 1958

My commission expires February 7, 1960

*[Handwritten Signature]*  
\_\_\_\_\_  
(Notary Public) for Oregon

(SEAL)

**CERTIFICATE OF REGISTRATION**

STATE OF OREGON

County of Marion

ss.

This is to certify that the foregoing Registration Statement was received in the office of the State Engineer on the 11th day of February, 1958, at \_\_\_\_\_ o'clock \_\_\_\_\_ M. and has been duly recorded in said office in Book No. 5 of Registration Statements on page 961

Witness my hand this 28 day of May, 1958

*[Handwritten Signature]*  
\_\_\_\_\_  
(State Engineer)

By \_\_\_\_\_  
(Deputy)