RECEIVED
JUL 1 1958
STATE ENGINEER
SALEM, OREGON

REGISTRATION NO. GR-994

Registration Statement

CERTIFICATE NO. GR-1111

OF CLAIMANT OF RIGHT TO APPROPRIATE GROUND WATER

(Under Chapter 708, Oregon Laws 1955.)

RECEIVED
JUL 1 1958
STATE ENGINEER
SALEM, OREGON

TO THE STATE ENGINEER OF OREGON:

I, Florence Rosow
2300 Highland Ave
of Grants Pass County of Josephine

State of Oregon, do hereby make application for a certificate of registration as evidence of a right to appropriate ground water.

1. **Source** from which water is withdrawn is Pump Well
(Flowing well, pump well, infiltration trench, or tunnel)

2. **Location is:** 1 mile North of Grants Pass, Ore.
(Approximate distance and direction from nearest city or town)

and is more particularly described as follows:

(a) 133 feet South and 433 feet East from NW cor. of NE 1/4 SW 1/4 of Sec. 6
(Give distance and bearing to corner of section or other legal subdivision)

being within NE 1/4 SW 1/4 (Smallest legal subdivision) of Sec. 6, Twp. 36 S (N. or S.), Rge. 5 W (E. or W.)

or (b) within limits of recorded platted property, town or city:

in Lot ..., Block ... of ... (Name of plat or addition)

... (If within city or town, give name) County of ...

3. **Construction Work** was begun on Aug. 1, 1953 (Date); was completed on Aug. 20, 1953 (Date)

and the ground water claimed was first used for the purposes set out below on Aug. 30, 1953 (Date)

since which time the water has been used Continuously (Continuously or intermittently)

from Aug. 30, 1953 (Date) to Feb. 1, 1958 (Date)

4. **Quantity** of water claimed and used is 40 gallons per minute; 330 acre feet per year.

5. **Purpose or Purposes** for which water is used
Irrigation
(Domestic, irrigation, municipal, manufacturing, industrial, etc.)

6. **Description of Well:** Depth 92 feet. Type Drilled (Dug or drilled)

diameter 8 inches. Elevation of ground at well site 1200 (As near as known) feet, mean sea level.

Depth to water table 30 feet.

7. **Capacity of Well:** 45 g.p.m. with 1 feet drawdown.

75 g.p.m. with 80 feet drawdown.

Date of test Aug. 20, 1953

If Flowing Well: Measured discharge ... g.p.m. on ... (Date)

Shut-in pressure at ground surface ... lbs. per sq. in. on ... (Date)

Water is controlled by ... (Cap, valve, etc.)

8. **Casing:** (Give diameter, commercial specifications and depth below ground surface of each casing size.)

8 inch diameter Casing from 1 to [illegible] feet

inch diameter from to feet

inch diameter from to feet

inch diameter from to feet

Describe and show depth of shoe, plug, adapter, liner or other details:

8" Guide shoe at 91 ft depth

9. **Perforated Casings or Screens:**

2 perforations per ft 1/4" Slot 2" + 3" (Number per foot and size of perforations, or describe screen) from 10 to 91'

from to

from to

from to

10. **Log of Well:** (Describe each stratum or formation clearly, indicate if water bearing, and give thickness and depth as indicated.)

MATERIAL	Thickness (Feet)	Depth to Bottom (Feet)
Granite and Sand	30	62
Granite -	50	12
Gravel and Granite (Water bearing)	10	2
Gravel (Water bearing)	2	

GR-1114

If log of well is not available, give name and address of driller. .....

.....

11. **Infiltration Trench:** Covered or open .....

Dimensions: Length ..... ft. Minimum depth ..... ft. Maximum depth ..... ft.

Bottom width ..... ft. Discharge ..... g.p.m. Date of test .....

12. **Tunnel:** Type of lining .....

Dimensions: ..... (Length, course, and cross section size)

Position of water bearing stratum with reference to portal of tunnel .....

.....

Log of tunnel: (Preceding table for log of well may be used, if desired. Give footage from portal and character of materials, as pertinent.)

13. **Pumping Equipment:**

(a) Pump *Dowand 2" Jet pump* (Make, type and size) Capacity *19* g.p.m.

(b) Motor *2 H.P. Electric Motor* (Type and horsepower).

14. Location of area irrigated or to be irrigated, or place of use if for purposes other than irrigation.

Township North or South	Range E. or W. of Willamette Meridian	Section	Forty-acre Tract	Number Acres To Be Irrigated	Date of Reclamation
36 S	5 W	6	NE 1/4 SW 1/4	7.0	Aug. 1953
(See description Tract 2)					

15. If the ground water supply is supplemental to an existing water supply, identification of any application for a permit, permit, certificate or adjudicated right to appropriate water made or held by the registrant.

.....

.....

GR-1114

Township 36 S. Range 5 W., W.M.

North

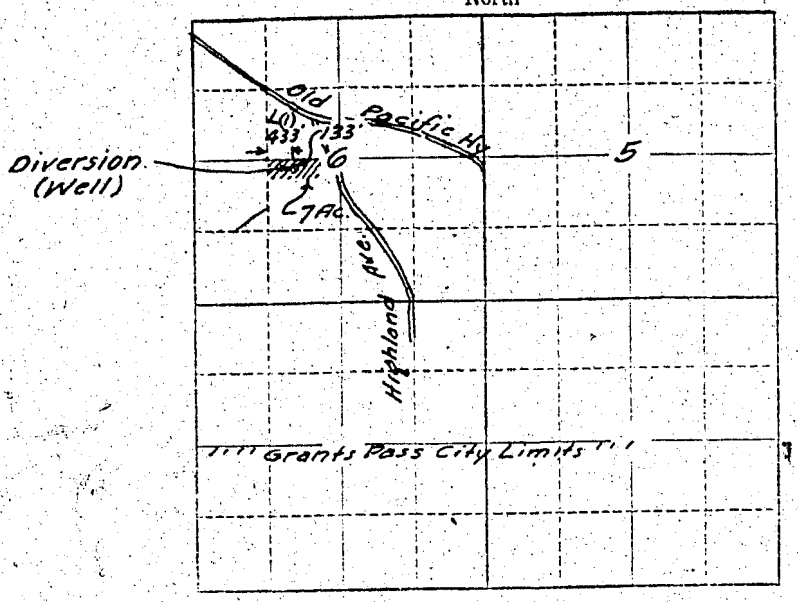

Locate well and acreage of irrigated land on plat.

Scale: 2" = 1 Mile

STATE OF OREGON
County of Josephine } ss.

I, Florence Rossow, being first duly sworn, do hereby certify that I have read the foregoing Registration Statement and that all of the items therein contained are true to the best of my knowledge and belief.

Florence Rossow
(Signature of Registrant)

Subscribed and sworn to before me this 27th day of January, 19 58

My commission expires Feb 27, 1961

Marjorie Urec
(Notary Public)

(SEAL)

CERTIFICATE OF REGISTRATION

STATE OF OREGON
County of Marion } ss.

This is to certify that the foregoing Registration Statement was received in the office of the State Engineer on the [illegible] day of [illegible], 19[illegible], at [illegible] o'clock [illegible] M. and has been duly recorded in said office in Book No. 6 of Registration Statements on page GR-1114

~~Contingent on beneficial use being completely applied to~~

Witness my hand this 20 day of August, 19 58

Lewis A. Stanley
(State Engineer)

By
(Deputy)

GR-1114