

Registration Statement

OF CLAIMANT OF RIGHT TO APPROPRIATE GROUND WATER

TO THE STATE ENGINEER OF OREGON:

I, George E Bond
 of Woodburn, Oreg County of Clatsop
(Mailing address)
 State of Oregon, do hereby make application for a certificate of registration as evidence of a right to appropriate ground water.

1. Source from which water is withdrawn is Spring well #1
(Flowing well, pump well, infiltration trench, or tunnel)

2. Location is: _____
(Approximate distance and direction from nearest city or town)

and is more particularly described as follows:

(a) 770 feet south & 350 feet west from N 1/4 corner section 30
(Give distance and bearing to corner of section or other legal subdivision)
 being within NE 1/4 of NW 1/4 of Sec. 30, Twp. 5 S, Rge. 1 E
(Smallest legal subdivision) (N. or S.) (E. or W.)

or (b) within limits of recorded platted property, town or city: _____
 in Lot _____, Block _____ of _____
(Name of plat or addition)

County of _____
(If within city or town, give name)

3. Construction Work was begun on Sept 1950; was completed on Oct 1951
(Date) (Date)

and the ground water claimed was first used for the purposes set out below on June 1952
(Date)

since which time the water has been used intermittently
(Continuously or intermittently)

from June 1952 to Sept 1957
(Date) (Date)

4. Quantity of water claimed and used is 70 gallons per minute; _____ acre feet per year.

5. Purpose or Purposes for which water is used irrigation

(Domestic, irrigation, municipal, manufacturing, industrial, etc.)

6. Description of Well: Depth 210 feet. Type drilled
(Dug or drilled)

diameter 6 inches. Elevation of ground at well site 215 feet, mean sea level.
(As near as known)

Depth to water table _____ feet.

7. Capacity of Well: 110 g.p.m. with 108 feet drawdown.

_____ g.p.m. with _____ feet drawdown.

Date of test Oct 1951

If Flowing Well: Measured discharge _____ g.p.m. on _____
(Date)

Shut-in pressure at ground surface _____ lbs. per sq. in. on _____
(Date)

Water is controlled by _____
(Cap, valve, etc.)

8. Casing: (Give diameter, commercial specifications and depth below ground surface of each casing size.)

6 inch diameter *steel casing* from 0 to 210 feet
 _____ inch diameter _____ from _____ to _____ feet
 _____ inch diameter _____ from _____ to _____ feet
 _____ inch diameter _____ from _____ to _____ feet

Describe and show depth of shoe, plug, adapter, liner or other details: _____

9. Perforated Casings or Screens:

eye torch slots from 40' to 210'
 (Number per foot and size of perforations, or describe screen)
 _____ from _____ to _____
 _____ from _____ to _____
 _____ from _____ to _____

10. Log of Well: (Describe each stratum or formation clearly, indicate if water bearing, and give thickness and depth as indicated.)

MATERIAL	Thickness (Feet)	Depth to Bottom (Feet)

If log of well is not available, give name and address of driller. J. J. Miller

11. Infiltration Trench: Covered or open

Dimensions: Length ft. Minimum depth ft. Maximum depth ft.

Bottom width ft. Discharge g.p.m. Date of test

12. Tunnel: Type of lining

Dimensions:
(Length, course, and cross sectional size)

Position of water bearing stratum with reference to portal of tunnel

Log of tunnel: (Preceding table for log of well may be used, if desired. Give footage from portal and character of materials, as pertinent.)

13. Pumping Equipment:

(a) Pump Reciprocating turbine Capacity 120 g.p.m.
(Make, type and size)


(b) Motor 1/2 H.P.
(Type and horsepower)

14. Location of area irrigated or to be irrigated, or place of use if for purposes other than irrigation.

Township North or South	Range E. or W. of Willamette Meridian	Section	Forty-acre Tract	Number Acres To Be Irrigated	Date of Reclamation
T58	R1E	30	NW 1/4 & NE 1/4	10	1952
"	"	"	NE 1/4 & NW 1/4	13	"
"	"	"	SW 1/4 & NE 1/4	2	"
"	"	"	SE 1/4 & NW 1/4	5	"
				30	

15. If the ground water supply is supplemental to an existing water supply, identification of any application for a permit, permit, certificate or adjudicated right to appropriate water made or held by the registrant.

Township 52 Range 1E, W.M.
North

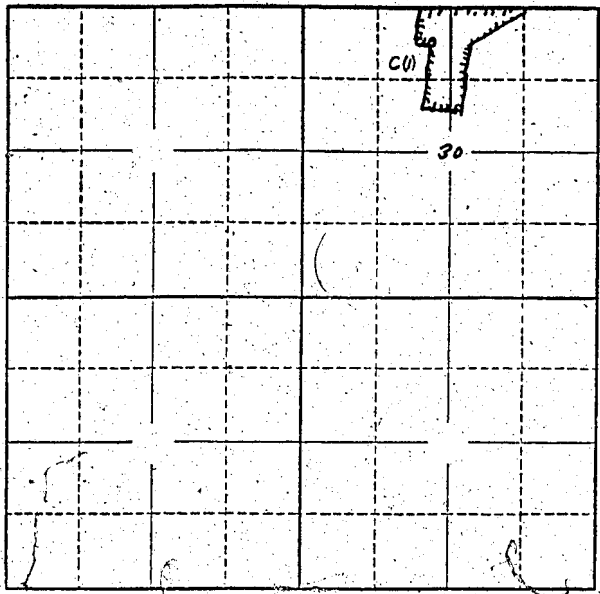

Locate well and acreage of irrigated land on plat.
Scale: 2" = 1/4 Mile

STATE OF OREGON }
County of Marion } ss.

I, _____, being first duly sworn, do hereby certify that I have read the foregoing Registration Statement and that all of the items therein contained are true to the best of my knowledge and belief.

George E. Bond
(Signature of Registrant)

Subscribed and sworn to before me this 11th day of February, 1958.

My commission expires 12th June 1961 W.M.S. Bartholomew
(Notary Public)

(SEAL)

CERTIFICATE OF REGISTRATION

STATE OF OREGON }
County of Marion } ss.

This is to certify that the foregoing Registration Statement was received in the office of the State Engineer on the 11 day of February, 1958, at 4:00 o'clock P.M. and has been duly recorded in said office in Book No. 5 of Registration Statements on page 963.

Witness my hand this 28 day of May, 1958

Lewis A. Stanley
(State Engineer)

By _____
(Deputy)