

RECEIVED
FEB 14 1950
STATE ENGINEER
SALES SECTION

Registration No. GR. 997
Certificate No. GR. 1518

Registration Statement

OF CLAIMANT OF RIGHT TO APPROPRIATE GROUND WATER

TO THE STATE ENGINEER OF OREGON:

I, The J. M. Smucker Company
of P. O. Box 87, Oregon City, Ore. County of Clackamas
(Mailing address)

State of Oregon, do hereby make application for a certificate of registration as evidence of a right to appropriate ground water.

1. Source from which water is withdrawn is Pump well
(Flowing well, pump well, infiltration trench, or tunnel)
2. Location is: 1 mile southeast of Oregon City on Beaver Creek Road
(Approximate distance and direction from nearest city or town)

and is more particularly described as follows:

Beginning South 89° West 1454.6 ft. from the Northeast corner of the Robert
(a) Caufield D.L.C. Thence N 35° E Sta. 722.08 to the S.W. of MKT Rd. Thence
S 22° 35' W 50' to the well (Give distance and bearing to corner of section or other legal subdivision)
being within Washington Williams of Sec. 9, Twp. 3 S, Rge. 2 E
(Smallest legal subdivision) D.L.C. (N. or S.) (E. or W.)

or (b) within limits of recorded platted property, town or city:
in Lot _____, Block _____ of _____
(Name of plat or addition)

County of _____
(If within city or town, give name)

3. Construction Work was begun on Jan. 1948; was completed on Feb. 1948
(Date) (Date)

and the ground water claimed was first used for the purposes set out below on Feb. 1948
(Date)
since which time the water has been used Continuously ~~intermittently~~
(Continuously or Intermittently)

from June 1, 1948 to Oct. 1, 1957 (Will be continuously from June 1, 1958)
(Date) (Date)

4. Quantity of water claimed and used is 140 gallons per minute; _____ acre feet per year.

5. Purpose or Purposes for which water is used fruit processing

(Domestic, irrigation, municipal, manufacturing, industrial, etc.)

6. Description of Well: Depth 390 feet. Type drilled
(Dug or drilled)

diameter 8 inches. Elevation of ground at well site 500 ft feet, mean sea level.
(As near as known)

Depth to water table 120 feet.

7. Capacity of Well: 140 g.p.m. with 210 feet drawdown.

150 g.p.m. with 235 feet drawdown.

Date of test Feb. 1948

If Flowing Well: Measured discharge _____ g.p.m. on _____
(Date)

Shut-in pressure at ground surface _____ lbs. per sq. in. on _____
(Date)

Water is controlled by _____
(Cap, valve, etc.)

8. Casing: (Give diameter, commercial specifications and depth below ground surface of each casing size.)

12 inch diameter pipe from surface to 23 feet
 8 inch diameter pipe from surface to 350 feet
 inch diameter from to feet
 inch diameter from to feet

Describe and show depth of shoe, plug, adapter, liner or other details:


9. Perforated Casings or Screens:

8 in. pipe perforated - two rows slots 5 per ft. from 62 to 347
(Number per foot and size of perforations, or describe screen) $1/4 \times 1 1/2"$
 from to
 from to
 from to

10. Log of Well: (Describe each stratum or formation clearly, indicate if water bearing, and give thickness and depth as indicated.)

MATERIAL	Thickness (Feet)	Depth to Bottom (Feet)
Soil	3	3
Gravel & Boulders	9	12
Solid rock, volcanic, med. hard	20	32
red shale, soft	10	42
brown shale, soft	20	62
Brown clay, silt origin	40	102
Blue clay, silt origin	40	142
Blue shale, light & dark streaks,	72	214
Sand on top of gravel mixed with clay	15	229
Green shale	10	239
Block sand, fairly coarse (green)	10	249
Light blue shale (fairly hard)	20	269
More silt visible (softer than above) changing to a greenish color	20	289
Dark green	10	299
Sand, rather fine (light in color)	10	309
Gray shale,	10	319
Shale, dark gray, hard & sticky	20	339
Dark blue shale (very hard)	40	379
Loose dark sand & gravel	10	389

Township 3 S Range 2 E W.M. North

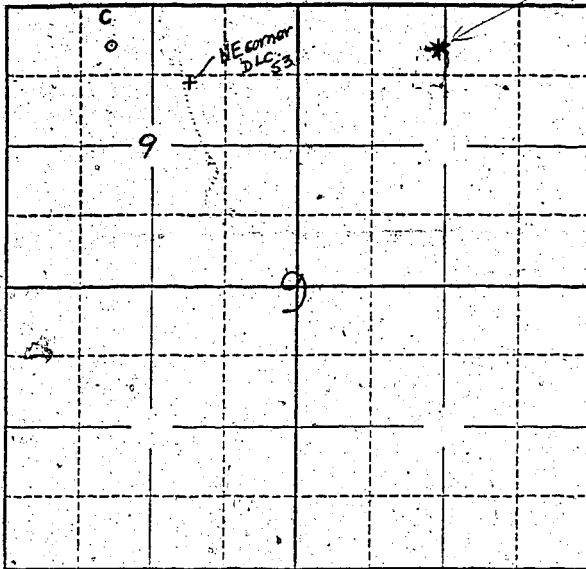

Locate well and acreage of irrigated land on plat.
Scale: 2" = 1 Mile

STATE OF OREGON

County of Cleckamas } ss.

The J. M. Smucker Co.

I, By: Ramus Brady, being first duly sworn, do hereby certify that I have read the foregoing Registration Statement and that all of the items therein contained are true to the best of my knowledge and belief.

[Handwritten Signature]
(Signature of Registrant)

Subscribed and sworn to before me this _____ day of _____, 1958.

My commission expires _____
(Notary Public)

(SEAL)

CERTIFICATE OF REGISTRATION

STATE OF OREGON } ss.
County of Marion

This is to certify that the foregoing Registration Statement was received in the office of the State Engineer on the 13th day of February, 1958, at 5:00 o'clock A. M. and has been duly recorded in said office in Book No. 7 of Registration Statements on page GR-1548

Witness my hand this 1st day of December 1958

[Handwritten Signature]
(State Engineer)

By _____ (Deputy)

GR-1548

20⁰⁰