


Township 55 Range 1W, W.M.
North

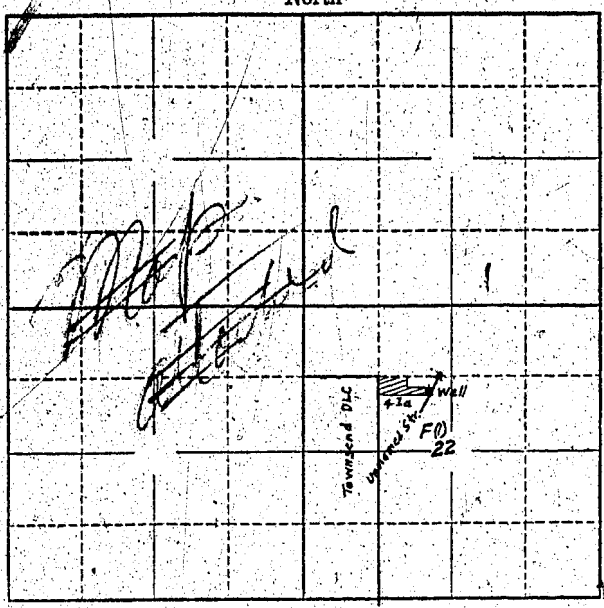

Locate well and acreage of irrigated land on plat.
Scale: 2" = 1 Mile

STATE OF OREGON }
County of Marion } ss.

I, John H. Bigler, being first duly sworn, do hereby certify that I have read the foregoing Registration Statement and that all of the items therein contained are true to the best of my knowledge and belief.

John H. Bigler
(Signature of Registrant)

Subscribed and sworn to before me this 18 day of August, 1955.

My commission expires Sept. 22, 1958.

Wm. H. Harris
(Notary Public)

(SEAL)

CERTIFICATE OF REGISTRATION

STATE OF OREGON }
County of Marion } ss.

This is to certify that the foregoing Registration Statement was received in the office of the State Engineer on the 18th day of August, 1955, at 11:00 o'clock A.M. and has been duly recorded in said office, in Book No. 1 of Registration Statements on page GR-1.

Construction shall be completed by _____, 19____, and the water ^{is} completely applied to beneficial use by _____, 19____.

Witness my hand this 24th day of February, 1956.

Lewis A. Stanley
(State Engineer)

By _____
(Deputy)