


TOWNSHIP 10S, RANGE 2W, W. M.

North

RD. 2

Gleason's Bridge

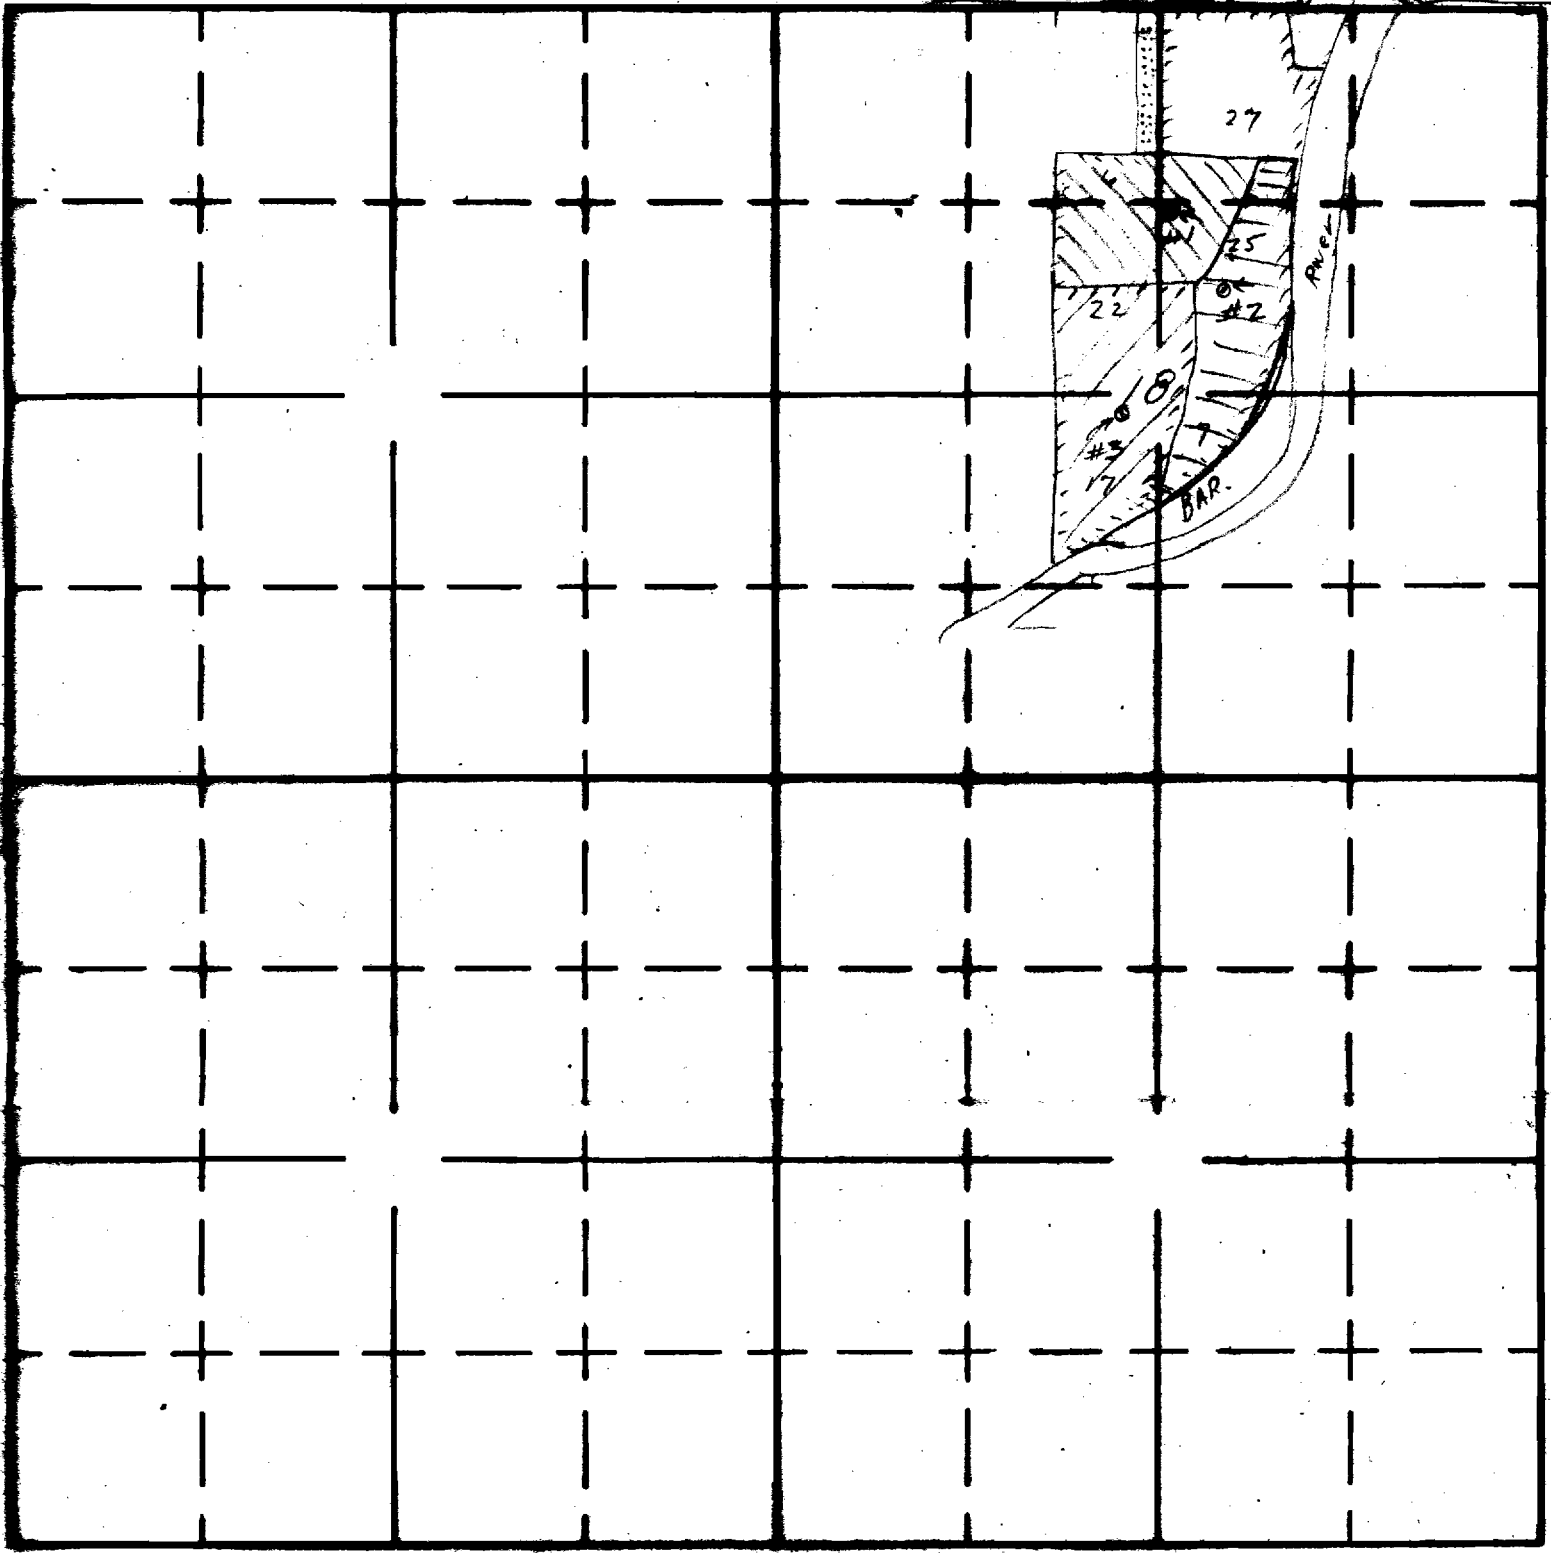

East