


Township 15S Range 4W, W.M.
North

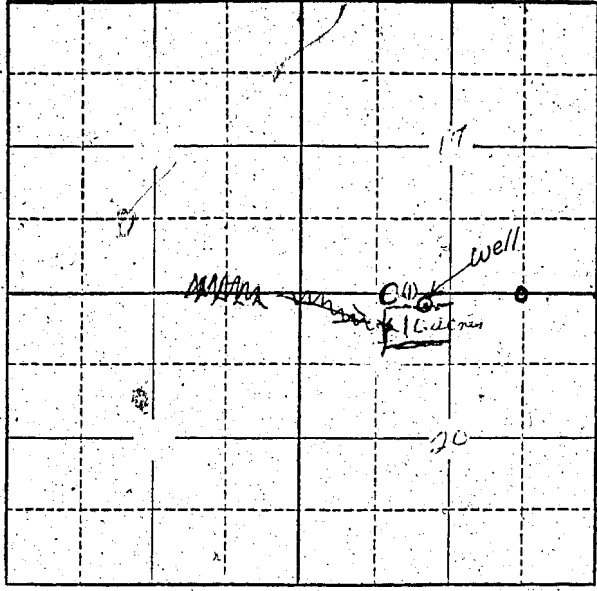

Locate well and acreage of irrigated land on plat.
Scale: 2" = 1 Mile

STATE OF OREGON

County of Same } ss.

I, Walter & Andrea Mickelson, being first duly sworn, do hereby certify that I have read the foregoing Registration Statement and that all of the items therein contained are true to the best of my knowledge and belief.

Walter E. Mickelson
(Signature of Registrant)

Subscribed and sworn to before me this 11 day of February, 1958

My commission expires April 20, 1960
Wm. Peterson
(Notary Public)

(SEAL)

CERTIFICATE OF REGISTRATION

STATE OF OREGON }
County of Marion } ss.

This is to certify that the foregoing Registration Statement was received in the office of the State Engineer on the 13 day of February, 1958, at 8:00 o'clock A. M., and has been duly recorded in said office in Book No. 5 of Registration Statements on page 975.

Witness my hand this 28 day of May, 1958.

Leura A. Stanley
(State Engineer)

By _____
(Deputy)