


North

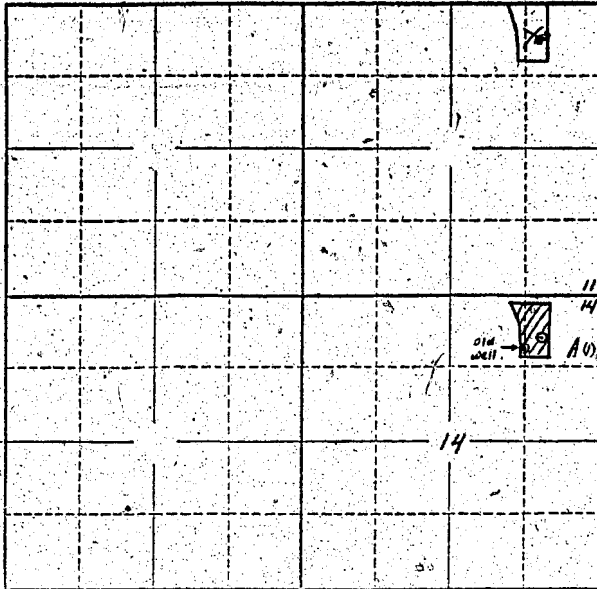

Locate well and acreage of irrigated land on plat.

Scale: 2" = 1 Mile

STATE OF OREGON

County of Lane } ss.

I, Edward A Bent, being first duly sworn, do hereby certify that I have read the foregoing Registration Statement and that all of the items therein contained are true to the best of my knowledge and belief.

Edward A Bent
(Signature of Registrant)

Subscribed and sworn to before me this 4 day of February, 1956

My commission expires Feb 26, 1958 Bert Mc Coy
(Notary Public)

(SEAL)

CERTIFICATE OF REGISTRATION

STATE OF OREGON

County of Marion } ss.

This is to certify that the foregoing Registration Statement was received in the office of the State Engineer on the 6th day of February, 1956, at 8:00 o'clock A.M. and has been duly recorded in said office in Book No. 1 of Registration Statements on page GR-95C

~~Construction shall be completed by _____ 19____ and the water completely applied to beneficial use by _____ 19____~~

Witness my hand this 12th day of April, 1956

Leino A. Stanley
(State Engineer)

By _____
(Deputy)