


North

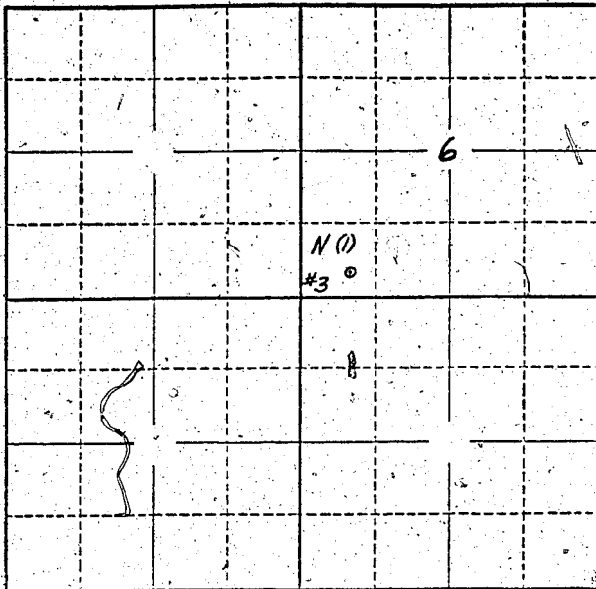

Locate well and acreage of irrigated land on plat.

Scale: 2" = 1 Mile

STATE OF OREGON

County of LINN } ss.

I, D. L. Cook, being first duly sworn, do hereby certify that I have read the foregoing Registration Statement and that all of the items therein contained are true to the best of my knowledge and belief.

*D. L. Cook*  
\_\_\_\_\_  
(Signature of Registrant)

Subscribed and sworn to before me this 13th day of February, 19 58

MY COMMISSION EXPIRES DEC. 4, 1958

My commission expires \_\_\_\_\_  
*James A. Stanley*  
\_\_\_\_\_  
(Notary Public)

(SEAL)

**CERTIFICATE OF REGISTRATION**

STATE OF OREGON } ss.  
County of Marion

This is to certify that the foregoing Registration Statement was received in the office of the State Engineer on the 17 day of February, 19 58, at 9:00 o'clock A. M. and has been duly recorded in said office in Book No. 5 of Registration Statements on page 986.

Witness my hand this 28 day of May, 19 58

*James A. Stanley*  
\_\_\_\_\_  
(State Engineer)

By \_\_\_\_\_  
(Deputy)