


North

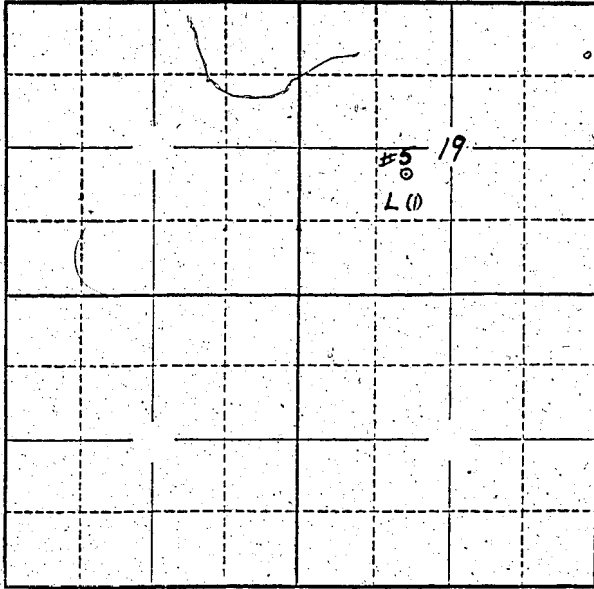

Locate well and acreage of irrigated land on plat.

Scale: 2" = 1 Mile

STATE OF OREGON

County of Marion

ss.

I, M. C. and/or Pearl Helms, being first duly sworn, do hereby certify that I have read the foregoing Registration Statement and that all of the items therein contained are true to the best of my knowledge and belief.

M.C. Helms
Pearl Helms
(Signature of Registrant)

Subscribed and sworn to before me this 11th day of February, 1958.

My commission expires

Marion A. Hutchings
(Notary Public)

(SEAL)

CERTIFICATE OF REGISTRATION

STATE OF OREGON

County of Marion

ss.

This is to certify that the foregoing Registration Statement was received in the office of the State Engineer on the 17th day of February, 1958, at 8:00 o'clock A.M. and has been duly recorded in said office in Book No. 5 of Registration Statements on page 993.

Witness my hand this 28th day of May, 1958.

Leura A. Stanley
(State Engineer)

By _____ (Deputy)