


North

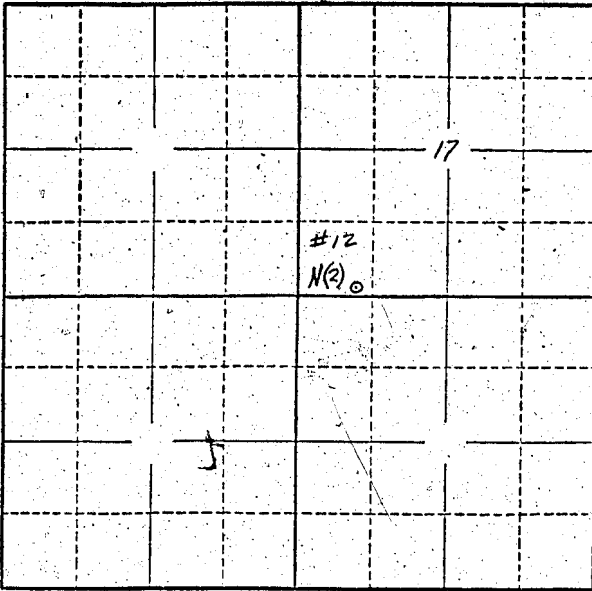

Locate well and acreage of irrigated land on plat.

Scale: 2" = 1 Mile

STATE OF OREGON

County of Marion } ss.

I, M. C. and/or Pearl Helms, being first duly sworn, do hereby certify that I have read the foregoing Registration Statement and that all of the items therein contained are true to the best of my knowledge and belief.

M. C. Helms  
Pearl Helms  
(Signature of Registrant)

Subscribed and sworn to before me this 11th day of February, 1958

My commission expires

Marvin A. Hutchings  
(Notary Public)

(SEAL)

Justice of the Peace, Jackson District  
Marion County, Oregon

CERTIFICATE OF REGISTRATION

STATE OF OREGON } ss.  
County of Marion

This is to certify that the foregoing Registration Statement was received in the office of the State Engineer on the 17 day of February, 1958, at 8:00 o'clock AM and has been duly recorded in said office in Book No. 52 of Registration Statements on page 1000

Witness my hand this 28 day of May, 1958

\$16.25

Lewis A. Stanley  
(State Engineer)

By \_\_\_\_\_ (Deputy)