


North

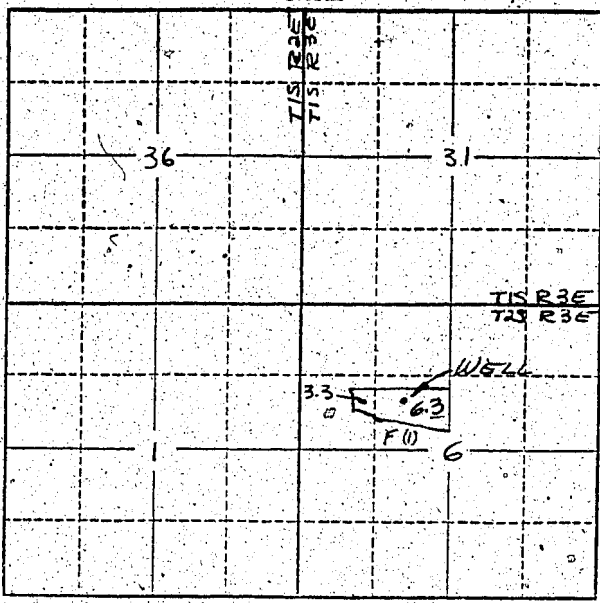

Locate well and acreage of irrigated land on plat.
Scale: 2" = 1 Mile

STATE OF OREGON
County of MULTNOMAH } ss.

I, LEWIS ISAACS, being first duly sworn, do hereby certify that I have read the foregoing Registration Statement and that all of the items therein contained are true to the best of my knowledge and belief.

Lewis Isaacs
(Signature of Registrant)

Subscribed and sworn to before me this 1 day of FEBRUARY, 1956

My commission expires _____
O. L. Westbook
(Notary Public)

(SEAL)

CERTIFICATE OF REGISTRATION

STATE OF OREGON } ss.
County of Marion

This is to certify that the foregoing Registration Statement was received in the office of the State Engineer on the 7th day of February, 1956, at 8:00 o'clock A.M. and has been duly recorded in said office in Book No. 1 of Registration Statements on page GR-96C

~~Construction shall be completed by _____ and the sum or sums completely applied to benefit of _____~~

Witness my hand this 12th day of April, 1956

Lewis A. Stender
(State Engineer)

By _____
(Deputy)