


24.96 Acres
Sec 28 + 33

Township 7S Range 2W W.M.
North

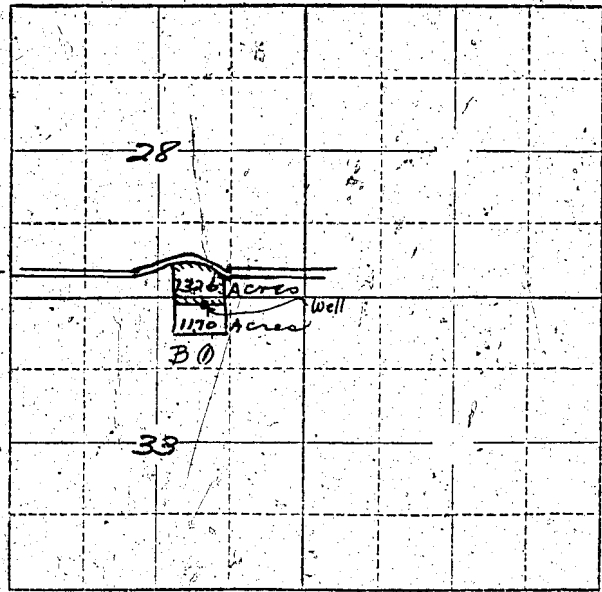

Locate well and acreage of irrigated land on plat.
Scale: 2" = 1 Mile

STATE OF OREGON

County of Marion } ss:

I, _____, being first duly sworn, do hereby certify that I have read the foregoing Registration Statement and that all of the items therein contained are true to the best of my knowledge and belief.

(Signature of Registrant)

Subscribed and sworn to before me this 17 day of Feb, 1958

MY COMMISSION EXPIRES JAN. 28, 1963

My commission expires _____

(Notary Public)

(SEAL)

CERTIFICATE OF REGISTRATION

STATE OF OREGON

County of Marion } ss:

This is to certify that the foregoing Registration Statement was received in the office of the State Engineer on the 17 day of Feb, 1958, at 11:00 o'clock A.M. and has been duly recorded in said office in Book No. 5 of Registration Statements on page 100.

~~Construction shall be completed by 1-1-59 and the water completely applied to beneficial use by 1-1-59.~~

Witness my hand this 28 day of May 1958

(State Engineer)

By _____
(Deputy)