


Township 6S Range 1W, W.M.
North

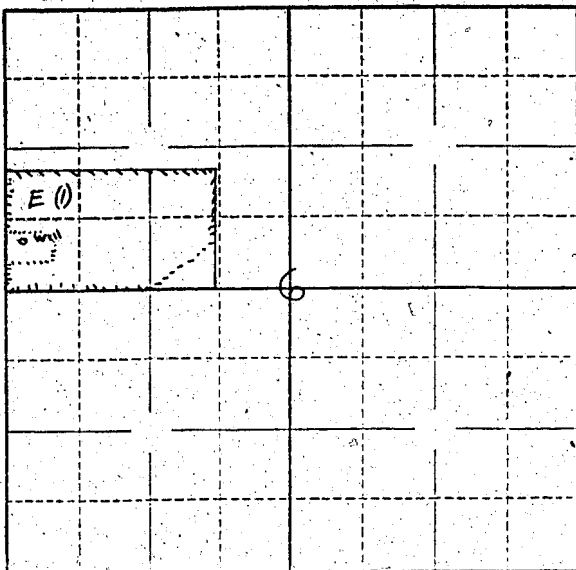

Locate well and acreage of irrigated land on plat.

Scale: $\frac{1}{4}$ " = 1 Mile

STATE OF OREGON

County of Oregon

ss.

I, Peter J. Miller, being first duly sworn, do hereby certify that I have read the foregoing Registration Statement and that all of the items therein contained are true to the best of my knowledge and belief.

Peter J. Miller
(Signature of Registrant)

Subscribed and sworn to before me this 20 day of February, 1958

My commission expires 9/27/58

Jeanne Baxter
(Notary Public)

(SEAL)

CERTIFICATE OF REGISTRATION

STATE OF OREGON

County of Marion

ss.

This is to certify that the foregoing Registration Statement was received in the office of the State Engineer on the 20th day of February, 1958, at 10:00 o'clock A. M. and has been duly recorded in said office in Book No. 5 of Registration Statements on page GR-1009C

Witness my hand this 30th day of June, 1958

Laura J. Miller
(State Engineer)

By

(Deputy)

GR - 1009 C