


Township 10 S Range 2 W W.M.
North

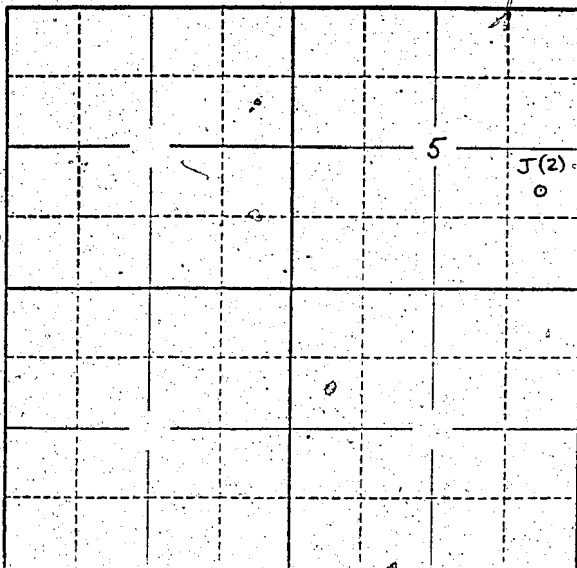

for Map see file
32140

Locate well and acreage of irrigated land on plat.

Scale: 2" = 1 Mile

STATE OF OREGON

County of

Marion

ss.

I, _____, being first duly sworn, do hereby certify that I have read the foregoing Registration Statement and that all of the items therein contained are true to the best of my knowledge and belief.

Subscribed and sworn to before me this 21st day of February, 1958

My commission expires 12th June 1961

Wm. S. Bartholomew
(Notary Public)

(SEAL)

CERTIFICATE OF REGISTRATION

STATE OF OREGON

County of Marion

ss.

This is to certify that the foregoing Registration Statement was received in the office of the State Engineer on the 21st day of February, 1958, at 9:00 o'clock H. M. and has been duly recorded in said office in Book No. 5 of Registration Statements on page GR-1017 C

Witness my hand this 30th day of June, 1958

Clara A. Stanley
(State Engineer)

By

(Deputy)

GR-1017 C