Township 16 S. Range 3 West W.M.

North

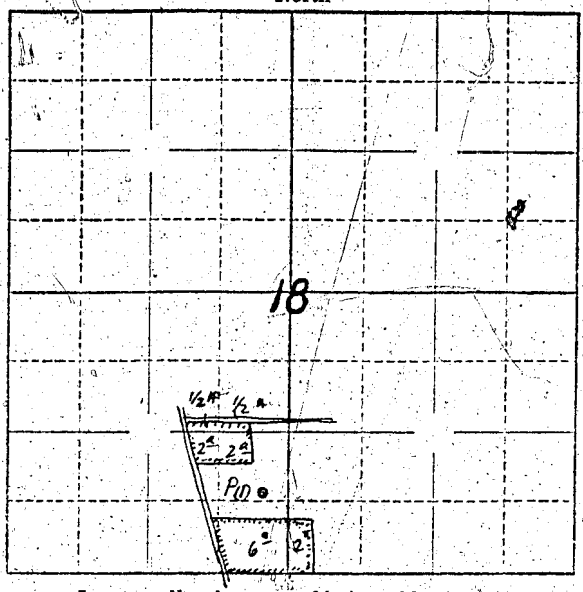

Locate well and acreage of irrigated land on plat.

Scale: 2" — 1 Mile

STATE OF OREGON)
County of Lane) ss.

I, Dwight Feulner, being first duly sworn, do hereby certify that I have read the foregoing Registration Statement and that all of the items therein contained are true to the best of my knowledge and belief.

(Signature of Registrant)

Subscribed and sworn to before me this 21st day of February, 19 58

My commission expires .....

(Notary Public)

(SEAL)

CERTIFICATE OF REGISTRATION

STATE OF OREGON)
County of Marion) ss.

This is to certify that the foregoing Registration Statement was received in the office of the State Engineer on the 24 day of February, 19 58, at 4 o'clock P.M. and has been duly recorded in said office in Book No. 5 of Registration Statements on page GR-1021 C

~~Conditions: This certificate of registration is issued subject to the rights of any person by reason of prior use of water and to the action of the Water Resources Board in determining the extent of the use.~~

Witness my hand this 30th day of June, 19 58

(State Engineer)

By .....

(Deputy)

GR-1021 C