


THE IRVIN CLAIM DOES NOT COINCIDE WITH THE 1/16 SECTION LINE IN THIS SECTION

7/10

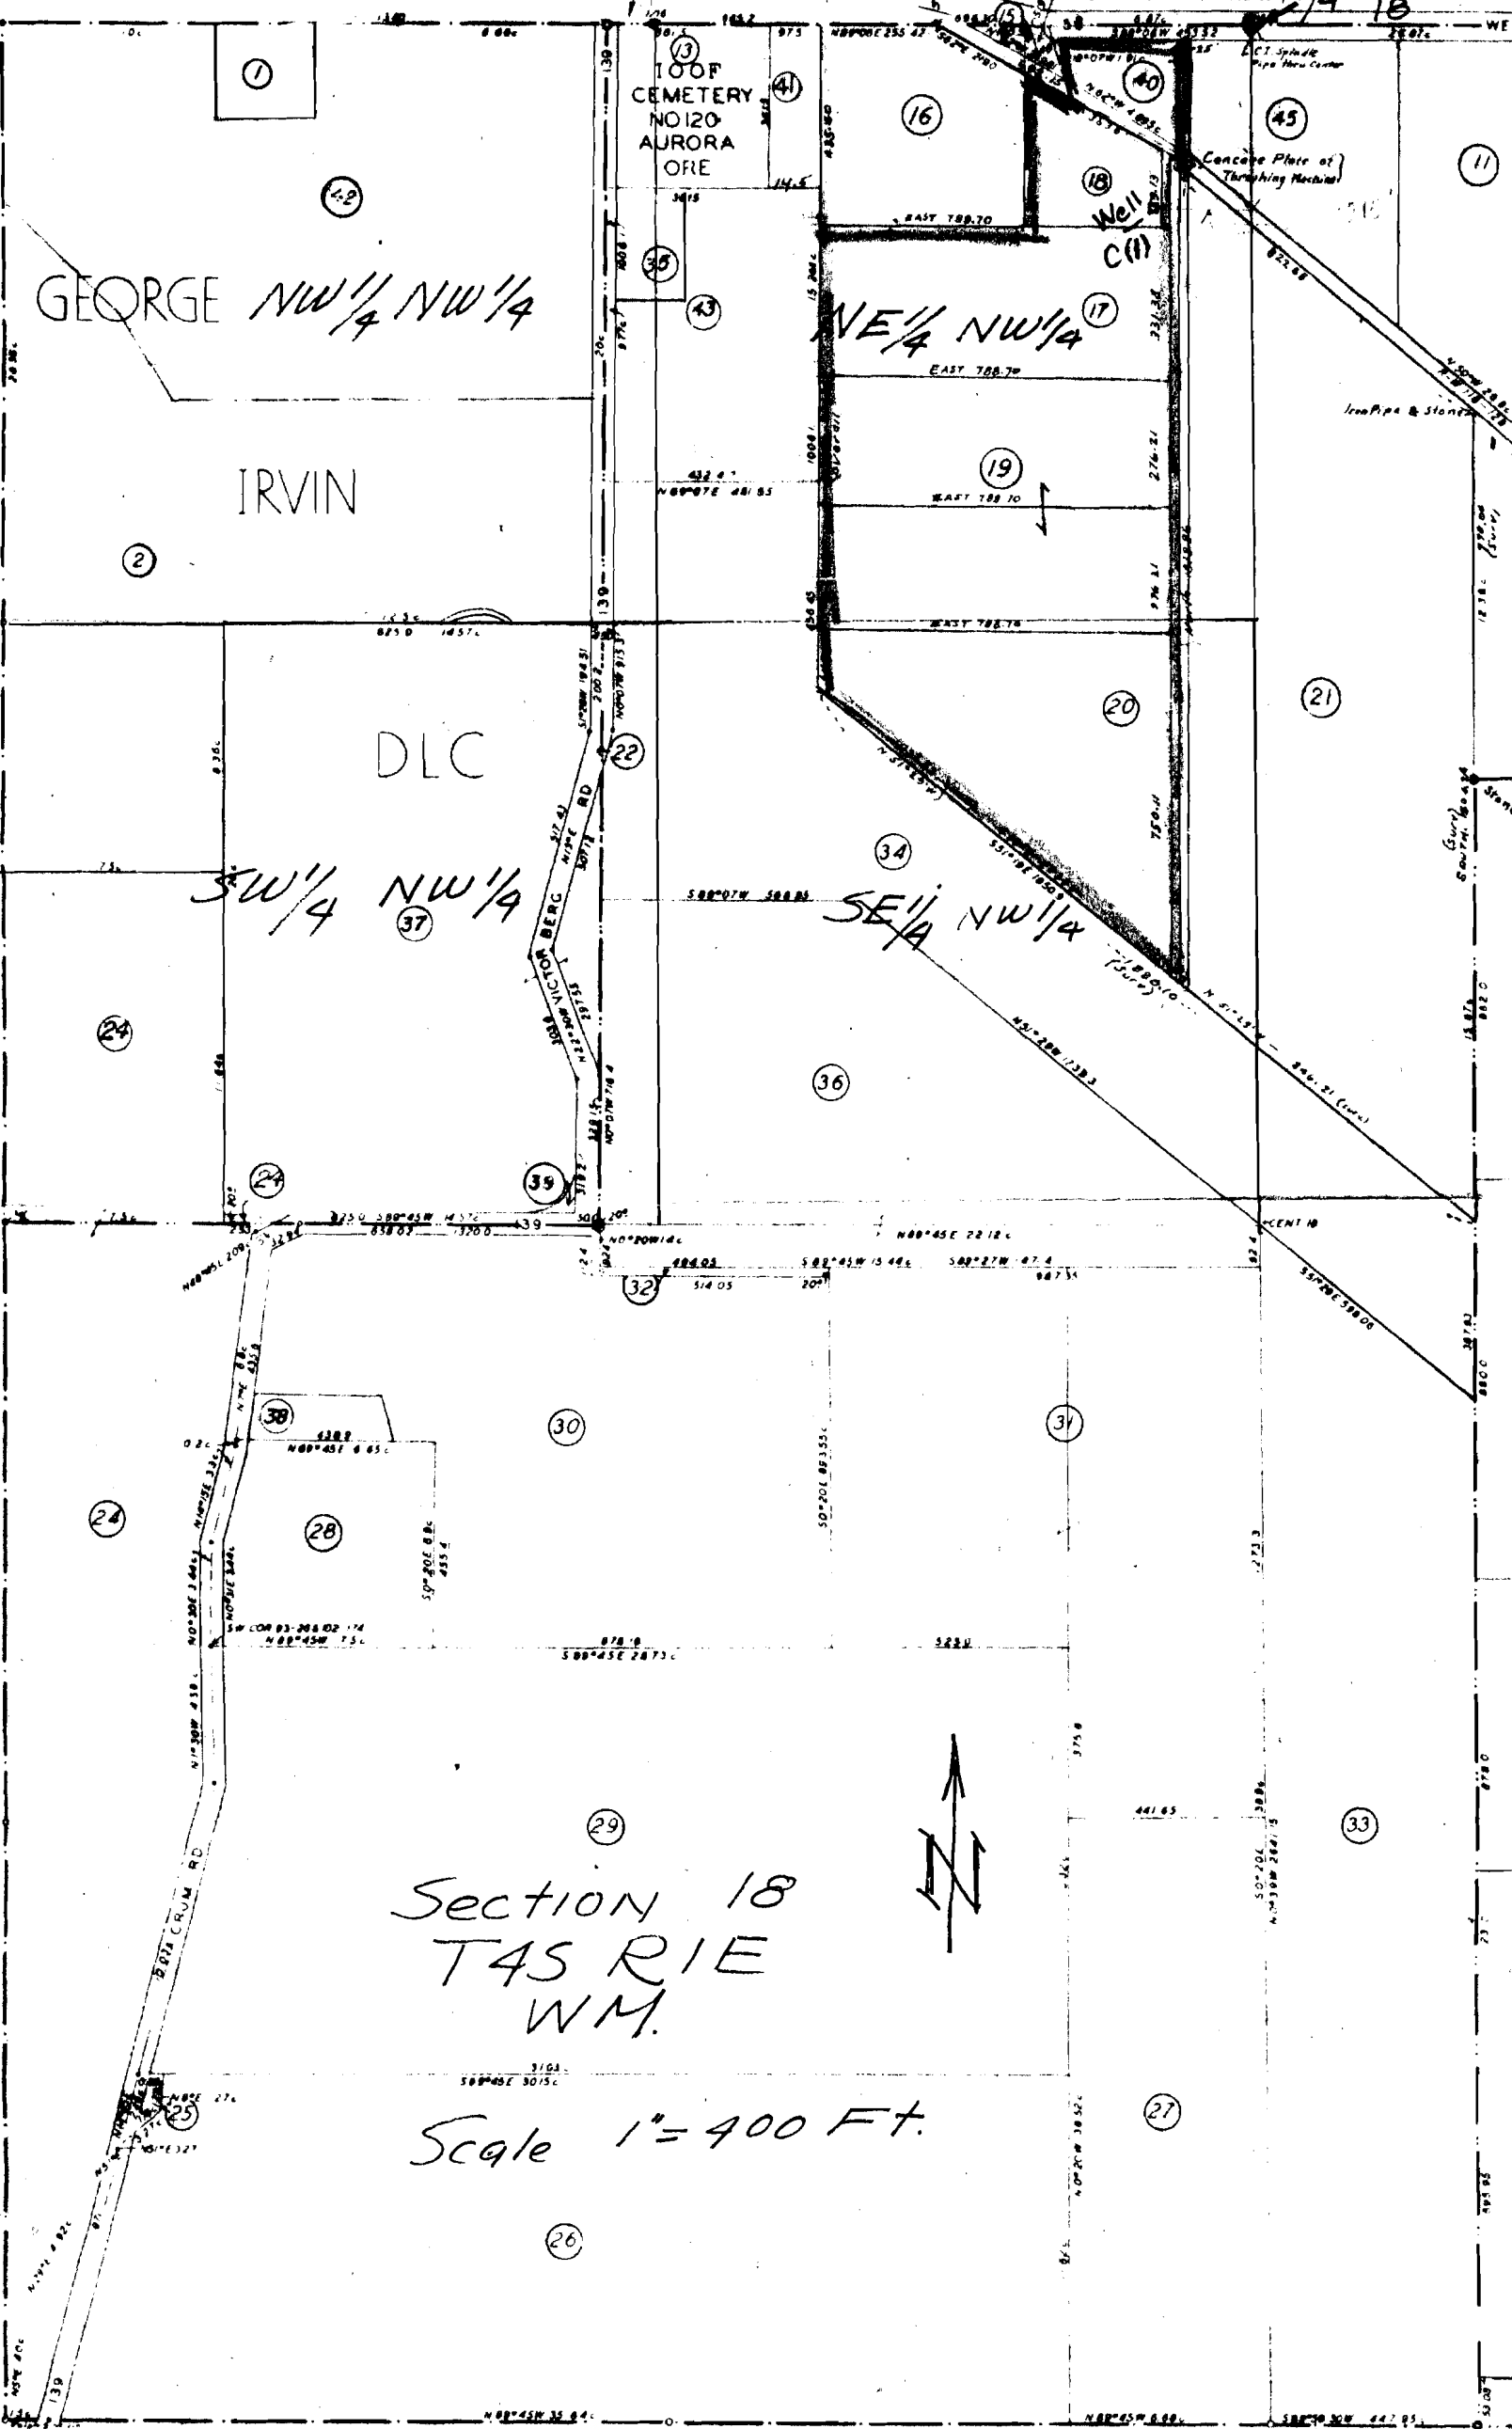

Section 18  
T45 R1E  
W1M.

Scale 1" = 400 Ft.

GR 1064