


Note: Photo indicates prop is located further to west.

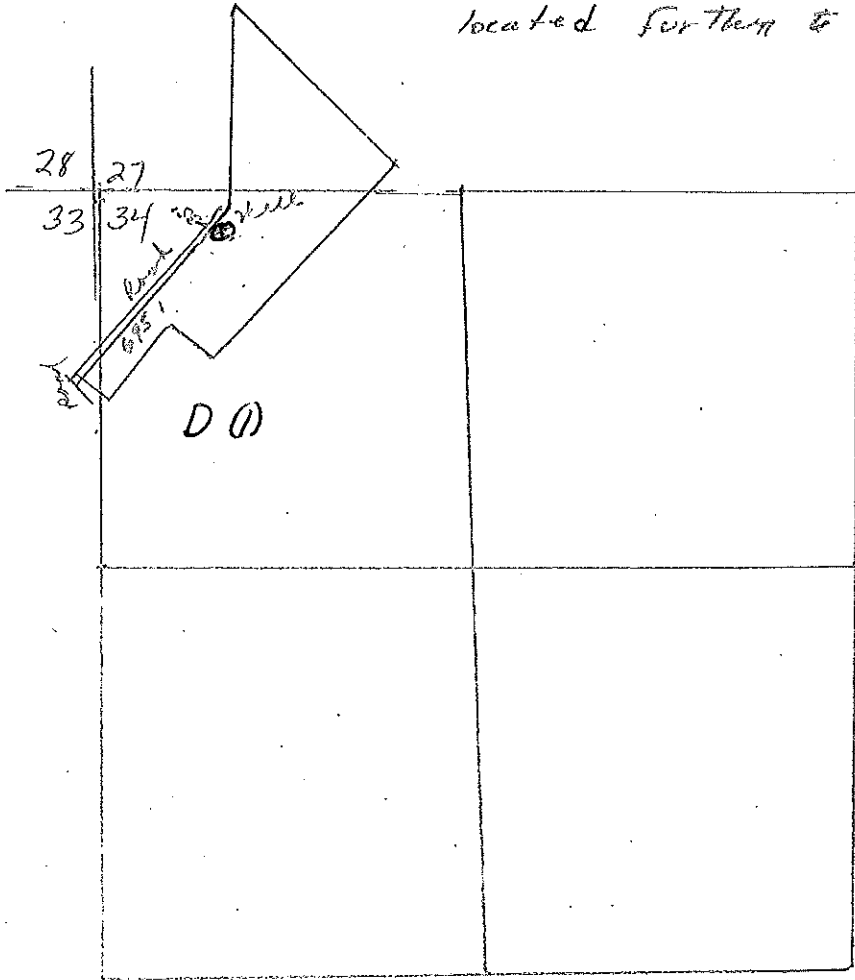

N. W. Section
N. W. Quarter
Sec. 34

RAY L Mortenson