


North

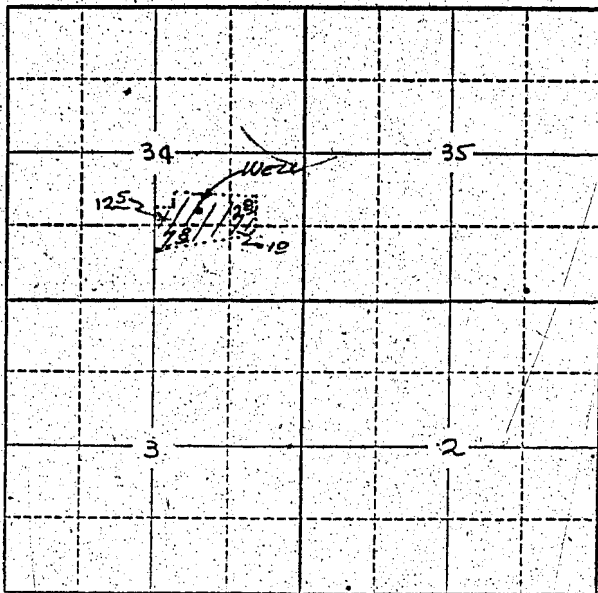

Locate well and acreage of irrigated land on plat.

Scale: 2" = 1 Mile

STATE OF OREGON

County of } SS.

I, being first duly sworn, do hereby certify that I have read the foregoing Registration Statement and that all of the items therein contained are true to the best of my knowledge and belief.

Emil P. Kraft
(Signature of Registrant)

Subscribed and sworn to before me this 9 day of February, 1956

My commission expires 2-18-1959 *H. J. Christ*
(Notary Public)

(SEAL)

CERTIFICATE OF REGISTRATION

STATE OF OREGON

County of Marion } SS.

This is to certify that the foregoing Registration Statement was received in the office of the State Engineer on the 14th day of February, 1956, at 8:00 o'clock A. M. and has been duly recorded in said office in Book No. 1 of Registration Statements on page GR-100C.

~~Construction shall be completed by and the water capacity applied or maintained by~~

Witness my hand this 12th day of April, 1956

Lewis A. Stanley
(State Engineer)

By
(Deputy)