


North

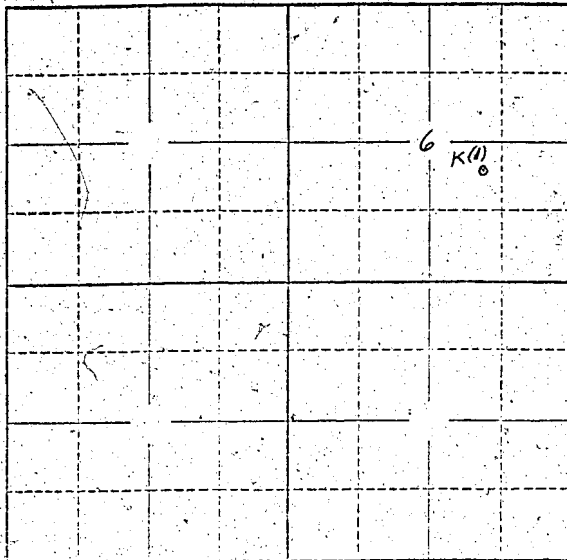

Locate well and acreage of irrigated land on plat.

Scale: 2" = 1 Mile

STATE OF OREGON

County of Linn

ss.

I, Ernest & Lena Gourley, being first duly sworn, do hereby certify that I have read the foregoing Registration Statement and that all of the items therein contained are true to the best of my knowledge and belief.

Ernest & Lena Gourley
Lena Gourley
 (Signature of Registrant)

Subscribed and sworn to before me this 25th day of February, 1958

My commission expires July 13, 1960

[Signature]
 (Notary Public)

(SEAL)

CERTIFICATE OF REGISTRATION

STATE OF OREGON

County of Marion

ss.

This is to certify that the foregoing Registration Statement was received in the office of the State Engineer on the 22 day of February, 1958, at o'clock M. and has been duly recorded in said office in Book No. 6 of Registration Statements on page GR 1071 C

Witness my hand this 30th day of June, 1958.

[Signature]
 (State Engineer)

By

(Deputy)

GR 1071 C