Township 4 S Range 1W, W.M.

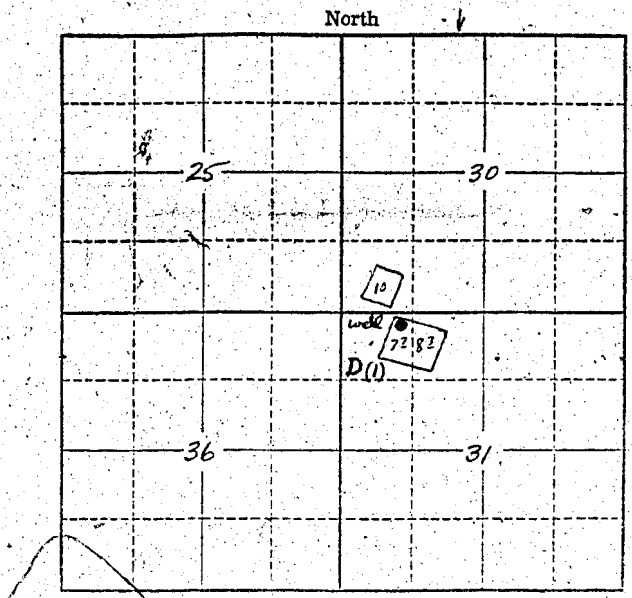

Locate well and acreage of irrigated land on plat.

Scale: 2" = 1 Mile

STATE OF OREGON)
County of Marion) ss.

I, Esther Lucas and I, Esther Lucas, being first duly sworn, do hereby certify that I have read the foregoing Registration Statement and that all of the items therein contained are true to the best of my knowledge and belief.

(Signature of Registrant)

Subscribed and sworn to before me this 26th day of February, 1958.

My commission expires March 21, 1959

(Notary Public) for Oregon.

(SEAL)

CERTIFICATE OF REGISTRATION

STATE OF OREGON)
County of Marion) ss.

This is to certify that the foregoing Registration Statement was received in the office of the State Engineer on the 4th day of ..., 19..., at ... o'clock ... M. and has been duly recorded in said office in Book No. 6 of Registration Statements on page GR-1072C

~~Construction shall be completed ... complete application of water to beneficial use by ...~~

Witness my hand this 30th day of June, 19 58

Lewis A. Stanley
(State Engineer)

By ...
(Deputy)

GR-1072C