


Township 65 Range 3W W.M.
North

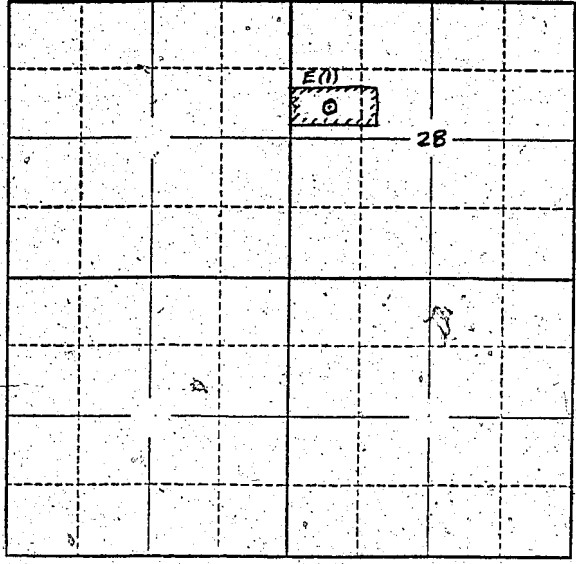

Locate well and acreage of irrigated land on plat.
Scale: 2" = 1 Mile

STATE OF OREGON }
County of Marion } ss.

I, _____, being first duly sworn, do hereby certify that I have read the foregoing Registration Statement and that all of the items therein contained are true to the best of my knowledge and belief.

Albert H. Pack
(Signature of Registrant)

Subscribed and sworn to before me this 5th day of March, 1958

My commission expires 12th June 1961 Wm. S. Bartholomew
(Notary Public)

(SEAL)

CERTIFICATE OF REGISTRATION

STATE OF OREGON }
County of Marion } ss.

This is to certify that the foregoing Registration Statement was received in the office of the State Engineer on the 5th day of March, 1958, at 11:00 o'clock P.M. and has been duly recorded in said office in Book No. 6 of Registration Statements on page GR-1074

Witness my hand this 30th day of June, 1958
Leura A. Stanley
(State Engineer)

By _____ (Deputy)