Township 25 Range 4E, W.M.

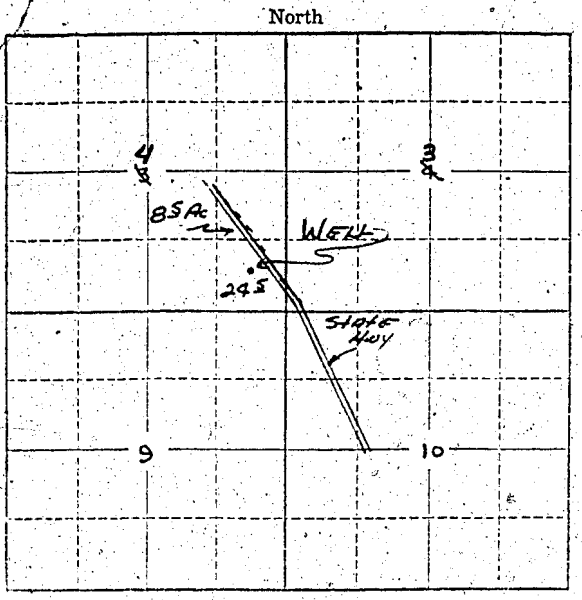

Locate well and acreage of irrigated land on plat.

Scale: 2" = 1 Mile

STATE OF OREGON)
County of [illegible]) ss.

I, [illegible], being first duly sworn, do hereby certify that I have read the foregoing Registration Statement and that all of the items therein contained are true to the best of my knowledge and belief.

[illegible]
(Signature of Registrant)

Subscribed and sworn to before me this [illegible] day of [illegible], 19[illegible].

My commission expires [illegible]

[illegible]
(Notary Public)

(SEAL)

CERTIFICATE OF REGISTRATION

STATE OF OREGON)
County of Marion) ss.

This is to certify that the foregoing Registration Statement was received in the office of the State Engineer on the [illegible] day of [illegible], 19[illegible], at [illegible] o'clock [illegible] M. and has been duly recorded in said office in Book No. 6 of Registration Statements on page GR-1[illegible]80

[illegible]pleted by [illegible]

Witness my hand this 30th day of June, 19 58

Lewis A. Stanley
(State Engineer)

By [illegible]
(Deputy)

GR-1[illegible]80