


11 Roda East from East line
 27 " North from North line

Township 6 N Range 33 E W.M.
 North

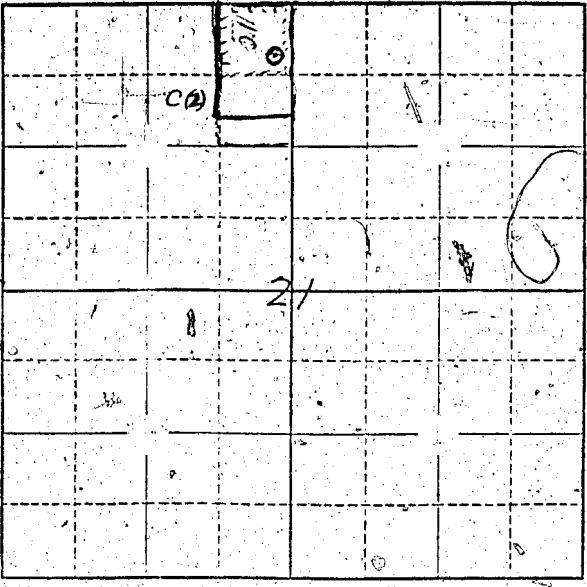

Locate well and acreage of irrigated land on plat.
 Scale: $\frac{2''}{4''} = 1 \text{ Mile}$

STATE OF OREGON

County of Umatilla } ss.

I, William C. Bade, being first duly sworn, do hereby certify that I have read the foregoing Registration Statement and that all of the items therein contained are true to the best of my knowledge and belief.

William C. Bade
 (Signature of Registrant)

Subscribed and sworn to before me this 6th day of March, 1958.

My commission expires Sept. 2, 1960 Walter H. Miller
 (Notary Public)

(SEAL)

CERTIFICATE OF REGISTRATION

STATE OF OREGON

County of Marion } ss.

This is to certify that the foregoing Registration Statement was received in the office of the State Engineer on the 10 day of March, 1958, at 3:00 o'clock A. M. and has been duly recorded in said office in Book No. of Registration Statements on page 1091

Witness my hand this 20 day of August, 1958.

Henry A. Miller
 (State Engineer)

By
 (Deputy)