


Township 6N Range 34E, W.M.
North

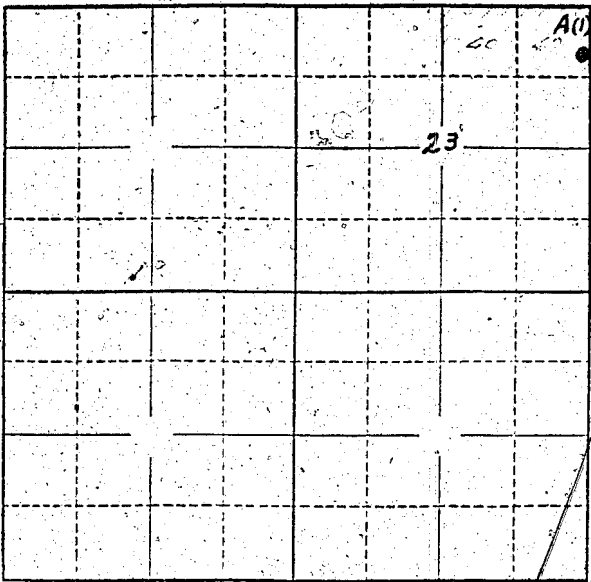

Locate well and acreage of irrigated land on plat.
Scale: 2" = 1 Mile

STATE OF OREGON

County of _____ } ss.

I, _____ being first duly sworn, do hereby certify that I have read the foregoing Registration Statement and that all of the items therein contained are true to the best of my knowledge and belief.

Edwin March
(Signature of Registrant)

Subscribed and sworn to before me this _____ day of _____, 19____.

My commission expires Sept 9, 1958 _____ (Notary Public)

(SEAL)

CERTIFICATE OF REGISTRATION

STATE OF OREGON } ss.
County of Marion

This is to certify that the foregoing Registration Statement was received in the office of the State Engineer on the 7 day of March, 1958, at 1:44 o'clock P.M. and has been duly recorded in said office in Book No. 6 of Registration Statements on page GR-1092

Witness my hand this 20 day of August, 1958

Lewis A. Stank
(State Engineer)

By _____ (Deputy)