


Township 6N Range 35, W.M.  
North

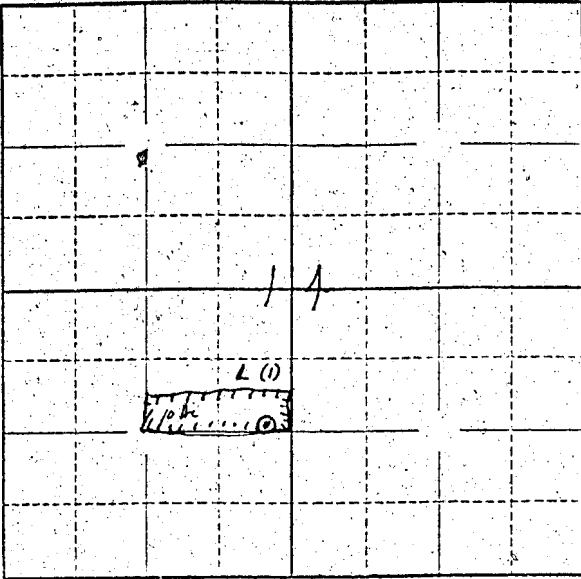

Locate well and acreage of irrigated land on plat.

Scale: 2" = 1 Mile

STATE OF OREGON

County of Umatilla } ss.

I, Herman Miller, being first duly sworn, do hereby certify that I have read the foregoing Registration Statement and that all of the items therein contained are true to the best of my knowledge and belief.

Herman Miller  
(Signature of Registrant)

Subscribed and sworn to before me this 6<sup>th</sup> day of March, 1958.

My commission expires Sept. 8, 1960  
Charles E. Miller  
(Notary Public)

(SEAL)

**CERTIFICATE OF REGISTRATION**

STATE OF OREGON

County of Marion } ss.

This is to certify that the foregoing Registration Statement was received in the office of the State Engineer on the \_\_\_\_\_ day of March, 1958, at 1:15 o'clock \_\_\_\_\_ M. and has been duly recorded in said office in Book No. 6 of Registration Statements on page GR-1195.

Witness my hand this 20 day of August, 1958.

Laura A. Johnson  
(State Engineer)

By \_\_\_\_\_  
(Deputy)