


North

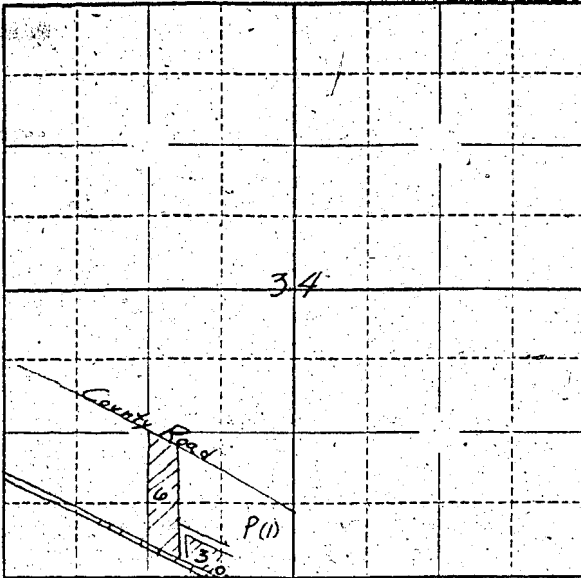

Locate well and acreage of irrigated land on plat.

Scale: 2" = 1 Mile
4"

STATE OF OREGON

County of Marion } ss.

I, Andrew Miller, being first duly sworn, do hereby certify that I have read the foregoing Registration Statement and that all of the items therein contained are true to the best of my knowledge and belief.

Andrew Miller
(Signature of Registrant)

Subscribed and sworn to before me this 15 day of August, 1958

My commission expires Sept 15 1959
(Notary Public)

(SEAL)

CERTIFICATE OF REGISTRATION

STATE OF OREGON } ss.
County of Marion

This is to certify that the foregoing Registration Statement was received in the office of the State Engineer on the 15 day of August, 1958, at 5:00 o'clock P. M. and has been duly recorded in said office in Book No. 6 of Registration Statements on page GR-1096

Witness my hand this 20 day of August, 1958

Lewis A. Stiney
(State Engineer)

By _____
(Deputy)