


Sunnyside North Hwy

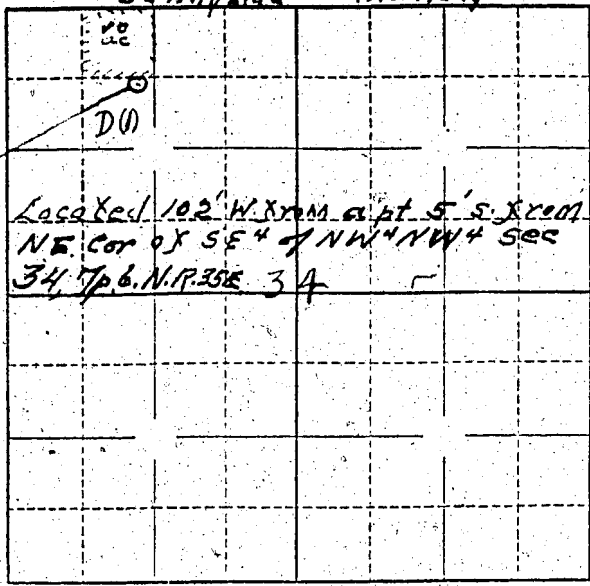

Locate well and acreage of irrigated land on plat.

Scale: 2" = 1 Mile
4" = 1 M.

STATE OF OREGON

County of Marion } ss.

I, John H. Bunker, being first duly sworn, do hereby certify that I have read the foregoing Registration Statement and that all of the items therein contained are true to the best of my knowledge and belief.

John H. Bunker
(Signature of Registrant)

Subscribed and sworn to before me this 10 day of March, 1958.

My commission expires Sept. 9, 1960

Clair [unclear]
(Notary Public)

(SEAL)

CERTIFICATE OF REGISTRATION

STATE OF OREGON

County of Marion } ss.

This is to certify that the foregoing Registration Statement was received in the office of the State Engineer on the 10 day of March, 1958, at 9:00 o'clock A. M. and has been duly recorded in said office in Book No. 6 of Registration Statements on page GR-1098

Witness my hand this 20 day of August, 1958.

Lewis A. Stanley
(State Engineer)

By _____
(Deputy)