


Township 6 N Range 34 E W.M.

North

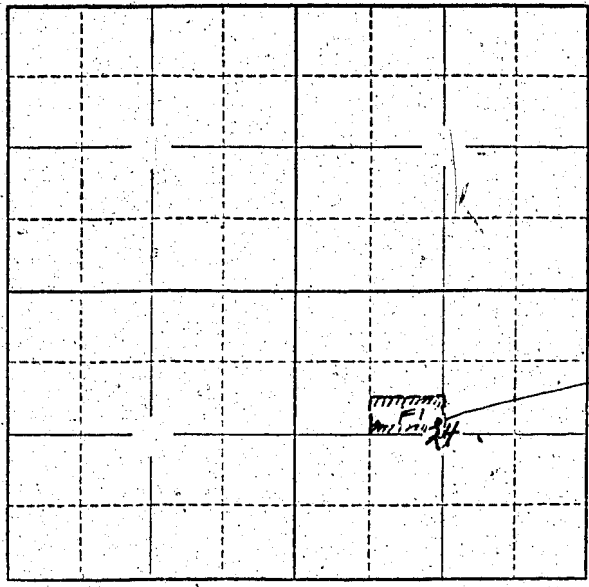

Well Location  
 150 feet North  
 7 feet West of  
 Center of Sec 24

Locate well and acreage of irrigated land on plat.  
 Scale: 2" = 1 Mile

STATE OF OREGON

County of Marion } ss.

I, Laura L. Richards, being first duly sworn, do hereby certify that I have read the foregoing Registration Statement and that all of the items therein contained are true to the best of my knowledge and belief.

[Signature]  
 (Signature of Registrant)

Subscribed and sworn to before me this 14 day of November, 1955.

My commission expires July 1, 1956  
 (Notary Public)

(SEAL)

### CERTIFICATE OF REGISTRATION

STATE OF OREGON

County of Marion } ss.

This is to certify that the foregoing Registration Statement was received in the office of the State Engineer on the 16 day of March, 1955, at 8:10 o'clock A. M. and has been duly recorded in said office in Book No. 6 of Registration Statements on page GR-1099.

Witness my hand this 20 day of August, 1958.

Lewis A. Stanley  
 (State Engineer)

By \_\_\_\_\_  
 (Deputy)