


Township 6N Range 35E W.M.
North

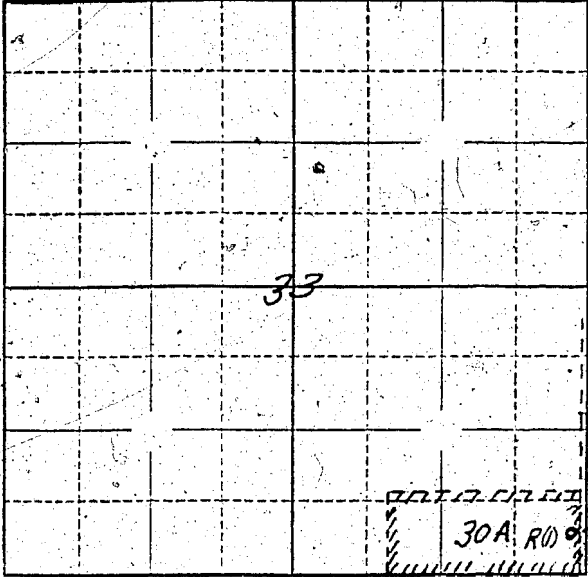

Locate well and acreage of irrigated land on plat.
Scale: $\frac{1}{4}$ - 1 Mile

Well Location
523 feet North of
SE Corner Sec 33
40ft West

STATE OF OREGON
County of Union } ss.

I, [Signature] being first duly sworn, do hereby certify that I have read the foregoing Registration Statement and that all of the items therein contained are true to the best of my knowledge and belief.

[Signature]
(Signature of Registrant)

Subscribed and sworn to before me this 11 day of August, 1958

My commission expires 11/1/58
(Notary Public)

(SEAL)

CERTIFICATE OF REGISTRATION

STATE OF OREGON }
County of Marion } ss.

This is to certify that the foregoing Registration Statement was received in the office of the State Engineer on the 16 day of March, 1958, at 8:00 o'clock P. M. and has been duly recorded in said office in Book No. 6 of Registration Statements on page GR-1104

Witness my hand this 20 day of August, 1958
[Signature]
(State Engineer)

By _____
(Deputy)