


North

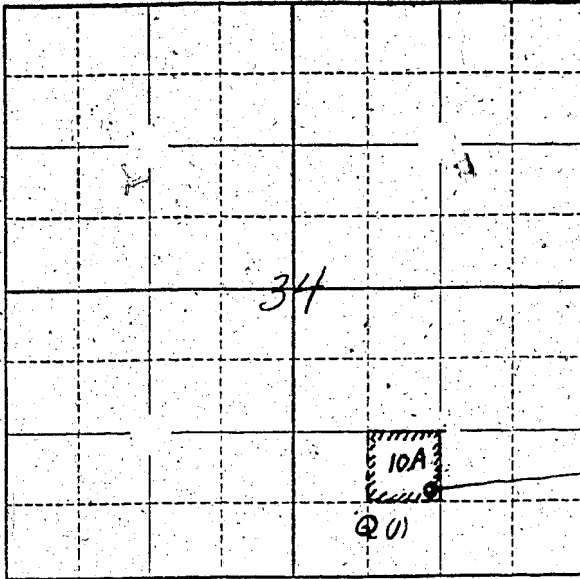

Location of well
660 feet South
of NE Corner of
the NE 1/4 of SW 1/4
of SE 1/4 of Sec 34

Locate well and acreage of irrigated land on plat.

Scale: $\frac{1}{4}$ - 1 Mile

STATE OF OREGON

County of Marion } ss.

I, Wilbur L. Gibbons being first duly sworn, do hereby certify that I have read the foregoing Registration Statement and that all of the items therein contained are true to the best of my knowledge and belief.

Wilbur L. Gibbons
(Signature of Registrant)

Subscribed and sworn to before me this 11 day of August, 1958.

My commission expires Sept 9, 1962 Notary Public

(SEAL)

CERTIFICATE OF REGISTRATION

STATE OF OREGON

County of Marion } ss.

This is to certify that the foregoing Registration Statement was received in the office of the State Engineer on the 10 day of March, 1958, at 8:00 o'clock A. M. and has been duly recorded in said office in Book No. 6 of Registration Statements on page GR-1112

Witness my hand this 20 day of August, 1958

Lewis A. Stanley
(State Engineer)

By _____ (Deputy)