


North

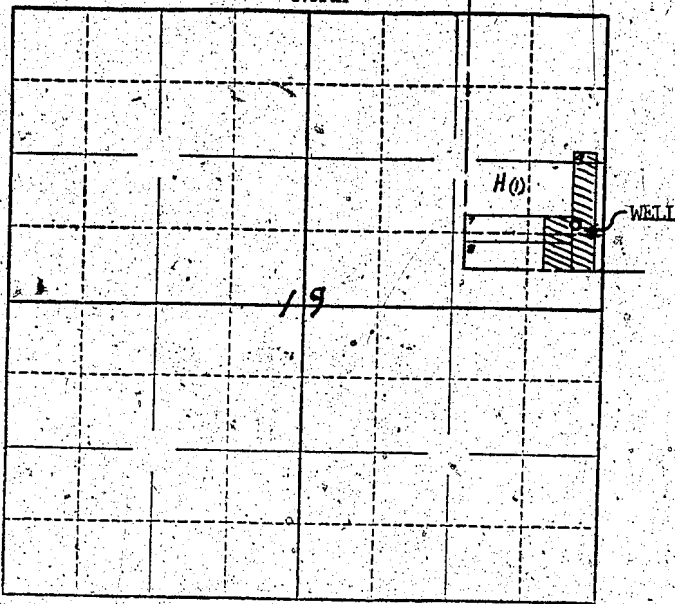

Locate well and acreage of irrigated land on plat.

Scale: $\frac{1}{4}$ " = 1 Mile
4" = "

STATE OF OREGON

County of Marion } ss.

I, Evel B. Huchat, being first duly sworn, do hereby certify that I have read the foregoing Registration Statement and that all of the items therein contained are true to the best of my knowledge and belief.

Evel B. Huchat
(Signature of Registrant)

Subscribed and sworn to before me this 9th day of February, 1956.

My commission expires Nov 15th 1956

[Signature]
(Notary Public)

(SEAL)

CERTIFICATE OF REGISTRATION

STATE OF OREGON }
County of Marion } ss.

This is to certify that the foregoing Registration Statement was received in the office of the State Engineer on the 15th day of February, 1956, at 10:40 o'clock A.M. and has been duly recorded in said office in Book No. 1 of Registration Statements on page GR-106.C

Construction shall be completed by _____ 19____ and the water completely applied to beneficial use by _____, 19____.

Witness my hand this 12th day of April, 1956

[Signature]
(State Engineer)

By _____
(Deputy)