


Township 6N Range 35E N.M.

North

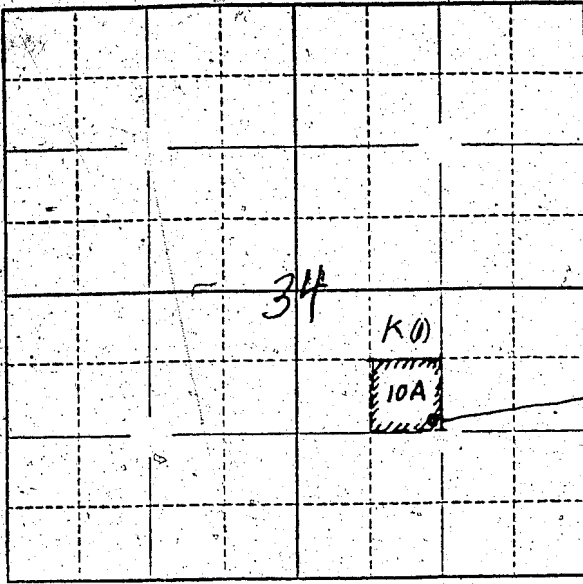

Location Well  
15 feet North & 15 feet  
West of SE Corner  
of the NW 1/4 of  
the SE 1/4 of Sec 34

Locate well and acreage of irrigated land on plat.

Scale:  $\frac{1}{4}$ " = 1 Mile

4"

ss.

STATE OF OREGON

County of Marion

I, William L. Libbers, being first duly sworn, do hereby certify that I have read the foregoing Registration Statement and that all of the items therein contained are true to the best of my knowledge and belief.

William L. Libbers  
(Signature of Registrant)

Subscribed and sworn to before me this 6<sup>th</sup> day of March, 1958

My commission expires Feb 5 1960  
(Notary Public)

(SEAL)

**CERTIFICATE OF REGISTRATION**

STATE OF OREGON }  
County of Marion } ss.

This is to certify that the foregoing Registration Statement was received in the office of the State Engineer on the 10 day of March, 1958, at 8:00 o'clock A. M. and has been duly recorded in said office in Book No. 6 of Registration Statements on page GR-1113

Witness my hand this 20 day of August, 1958

Leuro A. Stanley  
(State Engineer)

By \_\_\_\_\_  
(Deputy)