Township 6 N. Range 35 E., W.M.

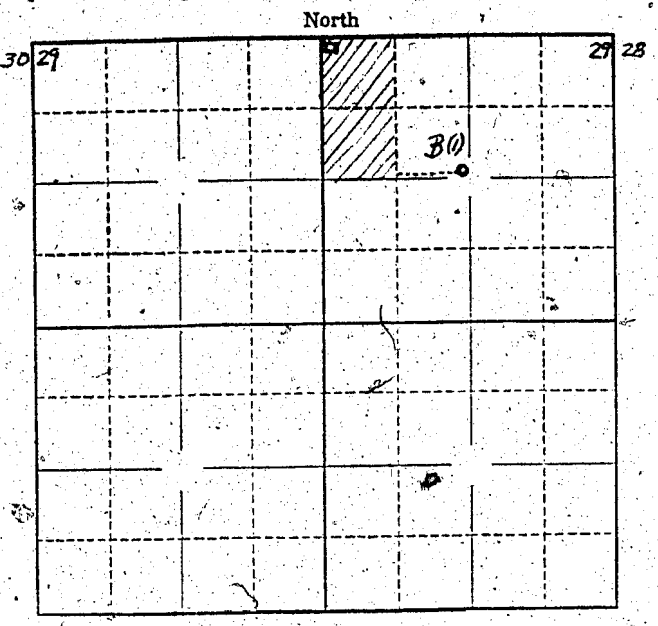


Locate well and acreage of irrigated land on plat.

Scale: 4 — 1 Mile

STATE OF OREGON }
County of [illegible] } ss.

I, [illegible], being first duly sworn, do hereby certify that I have read the foregoing Registration Statement and that all of the items therein contained are true to the best of my knowledge and belief.

[illegible]
(Signature of Registrant)

Subscribed and sworn to before me this [illegible] day of [illegible], 19[illegible].

My commission expires [illegible]

[illegible]
(Notary Public)

(SEAL)

## CERTIFICATE OF REGISTRATION

STATE OF OREGON }
County of Marion } ss.

This is to certify that the foregoing Registration Statement was received in the office of the State Engineer on the 11 day of May, 19[illegible], at [illegible] o'clock [illegible] M. and has been duly recorded in said office in Book No. 6 of Registration Statements on page GR-1121

Witness my hand this 20 day of August, 19 58

Lewis A. Stanley
(State Engineer)

By [illegible]
(Deputy)

GR-1121