

Locate well and acreage of irrigated land on plat.
Scale: 1/4" = 1 Mile

STATE OF OREGON

County of Marion

ss.

A. B. Hinz

being first duly sworn, do hereby certify that I have read the foregoing Registration Statement and that all of the items therein contained are true to the best of my knowledge and belief.

A. B. Hinz
(Signature of Registrant)

Subscribed and sworn to before me this 16th day of February, 1926.

My commission expires Sept. 8, 1956

Chas. J. Wheeler
(Notary Public)

(SEAL)

-CERTIFICATE OF REGISTRATION-

STATE OF OREGON

County of Marion

ss.

For certificate of registration see page GR-108 G

~~This is to certify that the foregoing Registration Statement was received in the office of the State Engineer on the _____ day of _____ 19____ and has been duly recorded in the _____ Book No. _____ of Registration Statements on page _____ Construction has been completed by _____ and the water completely applied to beneficial use by _____~~


Witness my hand this _____ day of _____ 19____

(State Engineer)

By _____ (Deputy)

Marion Church of God (Seventh Day)

GR-117 GR Modification

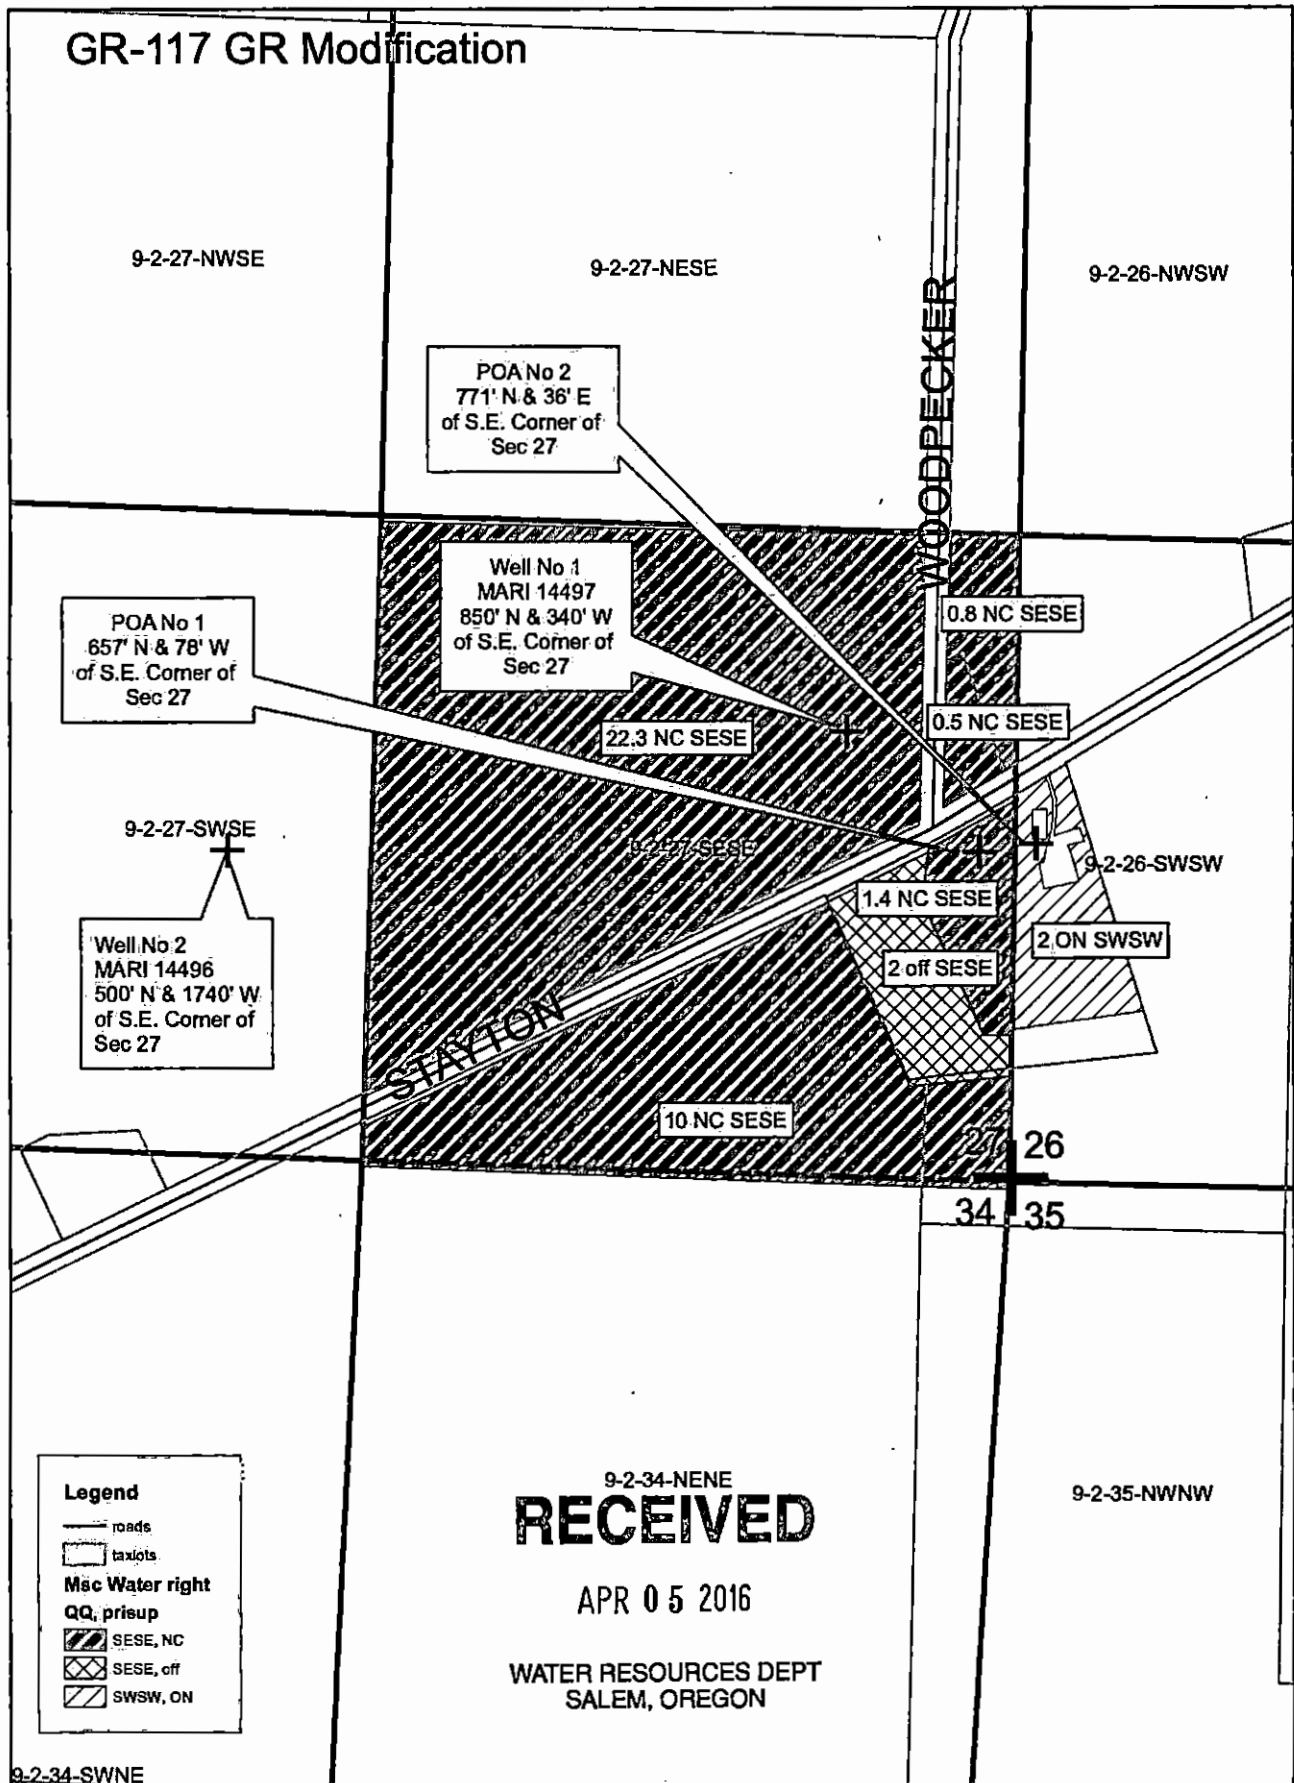

9-2-27-NWSE

9-2-27-NESE

9-2-26-NWSW

POA No 2
771' N & 36' E
of S.E. Corner of
Sec 27

POA No 1
657' N & 78' W
of S.E. Corner of
Sec 27

Well No 1
MARI 14497
850' N & 340' W
of S.E. Corner of
Sec 27

0.8 NC SESE

22.3 NC SESE

0.5 NC SESE

9-2-27-SWSE

Well No 2
MARI 14496
500' N & 1740' W
of S.E. Corner of
Sec 27


9-2-26-SWSW

1.4 NC SESE

2 ON SWSW

2 off SESE

10 NC SESE

26

34 35

9-2-35-NWNW

9-2-34-NENE

RECEIVED

APR 05 2016

WATER RESOURCES DEPT
SALEM, OREGON

Legend

- roads
- taxlots
- Mac Water right
- QQ, prisup
- SESE, NC
- SESE, off
- SWSW, ON

9-2-34-SWNE

400 200 0 400 Feet


Map prepared by Stevenson/McGill



T 12328

Marion Church of God (Seventh Day)

GR-117 GR Modification

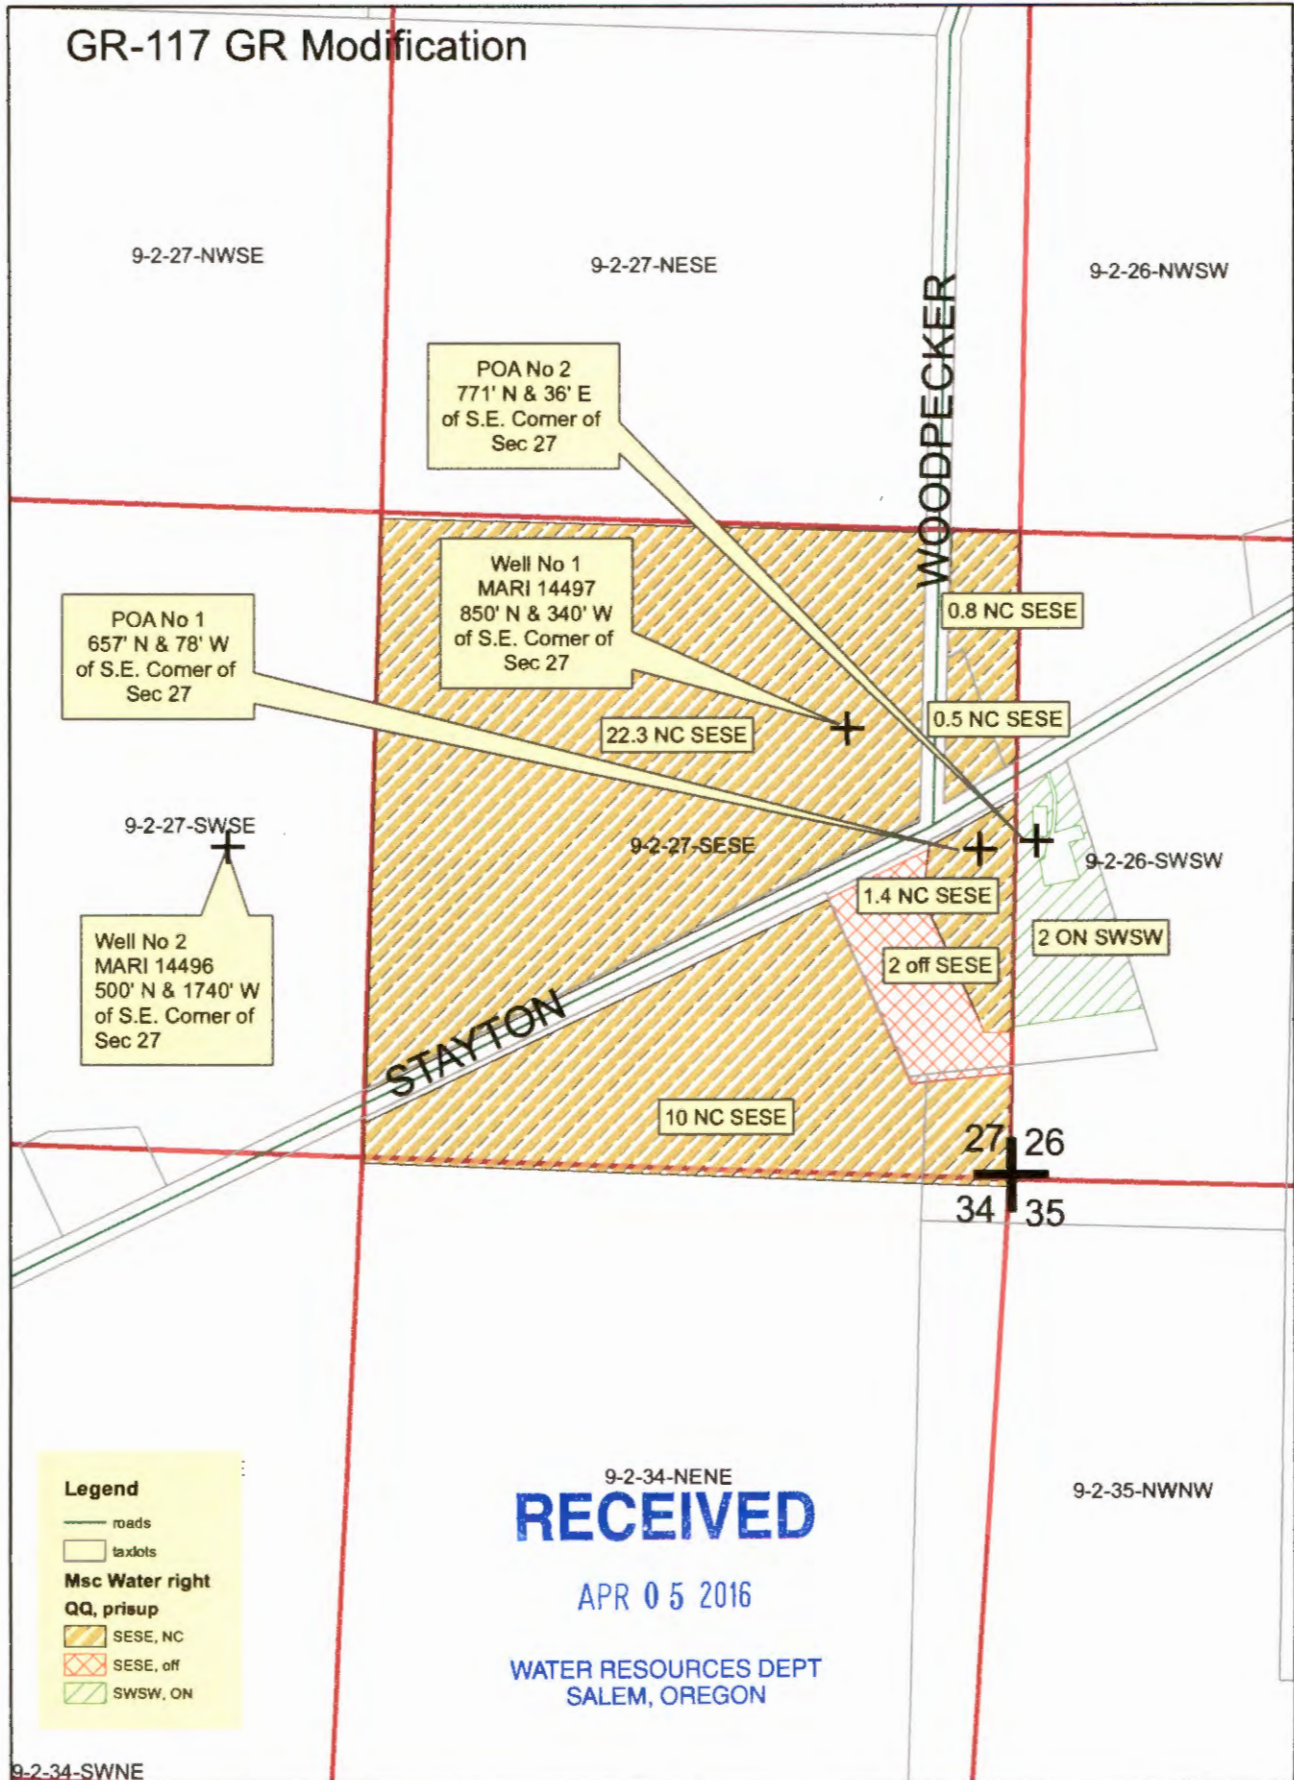

9-2-27-NWSE

9-2-27-NESE

9-2-26-NWSW

POA No 2
771' N & 36' E
of S.E. Corner of
Sec 27

POA No 1
657' N & 78' W
of S.E. Corner of
Sec 27

Well No 1
MARI 14497
850' N & 340' W
of S.E. Corner of
Sec 27

WOODPECKER

0.8 NC SESE

22.3 NC SESE

0.5 NC SESE

9-2-27-SWSE

Well No 2
MARI 14496
500' N & 1740' W
of S.E. Corner of
Sec 27

9-2-27-SESE

9-2-26-SWSW

1.4 NC SESE

2 ON SWSW

2 off SESE

STAYTON

10 NC SESE

27 26
34 35

Legend

- roads
- taxlots
- Misc Water right
- QQ, prispup
- SESE, NC
- SESE, off
- SWSW, ON

9-2-34-NENE
RECEIVED

APR 05 2016

WATER RESOURCES DEPT
SALEM, OREGON

9-2-35-NWNW

9-2-34-SWNE

400 200 0 400 Feet

Map prepared by Stevenson/McGill



T 12328